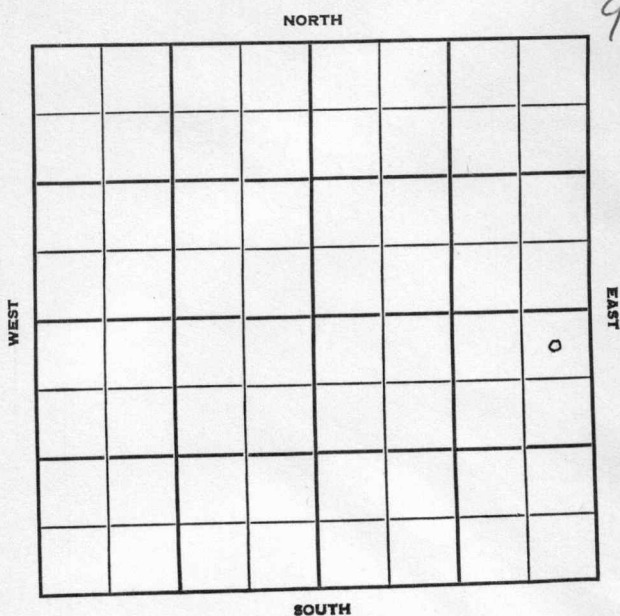


FORM 51 25M 3-49 PETROL

KANSAS

Section 12 Township 18 Range 15-WWell No. #1 OpieCompany Ed Adair

Sec. 12 Twp. 18 R. 15W

Well No. #1 Opie Farm

Ed Adair Company

Contractor


330' Ft. from N. Line

 Ft. from S. Line

330' Ft. from E. Line

 Ft. from W. Line

NE NE SE

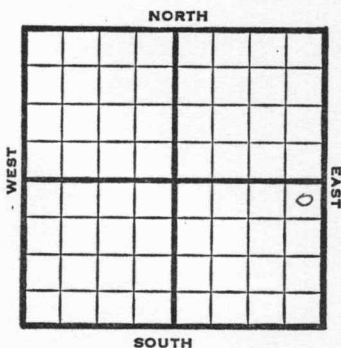

1950

Elev 1964

REPORT

5/24

Locationn

6/14

8" @ 258
Heeb 3209
Lans. 3279
B KC 3515
Cong. 3554
Arb. 3570
TD 3620
D&A

ABANDONED

Kansas

Map No. _____ Sec. 12 Twp. 18 R. 15WWell No. 1 OpieEd Adair Company_____
Contractor

NE NE SE


SECTION PLAT

330 Ft. from N. Line

_____ Ft. from S. Line

330 Ft. from E. Line

_____ Ft. from W. Line

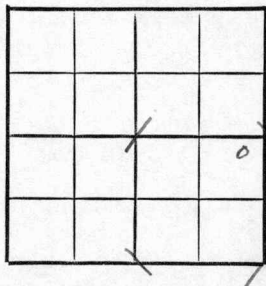BartonLocation X

Rig up _____

Drilling and Remarks:

RECORD

Cased _____ in., _____ ft.

Sand _____

Gas _____

Oil _____

Total Depth _____

PRODUCTION

1st 24 hrs. Nat. _____

1st 24 hrs. after shot _____

Gas _____ Cu. Ft.

Dry Hole _____

Abandoned _____

Date

MAY 24 1950

19

J. E. TYRA

Scout

Kansas

Map No. _____ Sec. 12 Twp. 18 R. 15WWell No. 1 OpieEd Adair Company

Contractor

NE NE SE

E1. 1964

SECTION PLAT

330 Ft. from N. Line

Ft. from S. Line

330 Ft. from E. Line

Ft. from W. Line



Barton County

Location _____

Rig up _____

Drilling and Remarks:

8" @ 258

Heeb. 3209

Lans. 3279

B KC 3515

Cong. 3554

Arb. 3570

TD 3620

RECORD

Cased _____ in., _____ ft.

Sand _____

Gas _____

Oil _____

Total Depth 3620

PRODUCTION

1st 24 hrs. Nat. _____

1st 24 hrs. after shot _____

Gas _____ Cu. Ft.

Dry Hole _____

Abandoned _____

D & A
Date

JUN 14 1950 19

J. E. TYRA Scout