


Section 18 Township 18 Range 15-W

Well Number #1 Krause

Company Helmerick & Payne

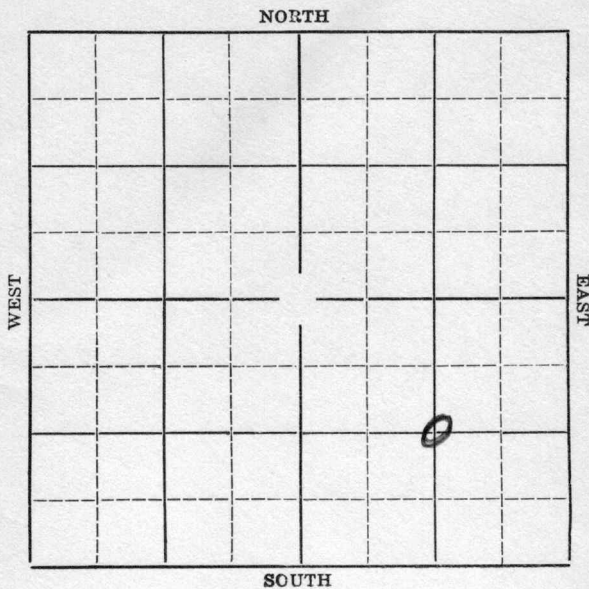

**KANSAS**

Barton

Sec. 18 Twp. 18 R. 15-W

Well No. 1 Krause Farm

Helmerick & Payne Company


\_\_\_\_\_ Ft. from N. Line

1320 Ft. from S. Line

1320 Ft. from E. Line

\_\_\_\_\_ Ft. from W. Line

*Elev. 1951*

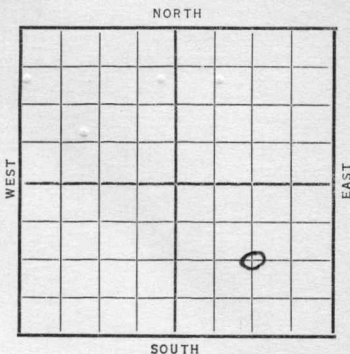

1936	REPORT
11/4	Location
11/12	-----11/19--
11/27	R O G
12/3	"
12/10	Rig.
12/17	15" @ 162'. Drlg.
12/24	Drlg. 865'.
12/29	Drlg. 1120'.
1937	
1/7	Drlg. 2516'.
1/14	Drlg. 3050'.
1/21	Drlg. 3435'.
1/28	Sand 3493'. 7" @ 3495'.
	T. D. 3513'. Rust.
2/4	Drlg. plug 15 M gas
2/11	Shut Down
2/19	" "
	OVER
	OVER

1937

2/24 Basil Sand 3493'.

T. D. 3515'.

27 M gas.

COMPLETED

**KANSAS**

Map No. 73 Sec. 18 Twp. 18 R. 15W

Well No. 1 Krause

Helmerich & Payne Company

Contractor

**SECTION PLAT**


\_\_\_\_\_ Ft. from N. Line

1320 Ft. from S. Line

1320 Ft. from E. Line

\_\_\_\_\_ Ft. from W. Line

FIRST REPORT

Location ✓

Rig up \_\_\_\_\_

Drilling and Remarks:

**RECORD**

Cased \_\_\_\_\_ in., \_\_\_\_\_ ft.

Sand \_\_\_\_\_

Gas \_\_\_\_\_

Oil \_\_\_\_\_

Total Depth \_\_\_\_\_

**PRODUCTION**

1st 24 hrs. Nat. \_\_\_\_\_

1st 24 hrs. after shot \_\_\_\_\_

Gas \_\_\_\_\_ Cu. Ft.

Dry Hole \_\_\_\_\_

Abandoned \_\_\_\_\_

Date

NOV 4 1936

19

S. J. LEWIS

Scout

Map No. 73 Sec. 18 Twp. 18 R. 15W

Well No. 1 Krause

Helmerich & Payne Company

Contractor

### SECTION PLAT

			o

\_\_\_\_\_ Ft. from N. Line

1320 Ft. from S. Line

1320 Ft. from E. Line

\_\_\_\_\_ Ft. from W. Line

COMPLETED

Location \_\_\_\_\_

Rig up \_\_\_\_\_

Drilling and Remarks:

Basil Sand

8493

27 M Gas

### RECORD

Cased \_\_\_\_\_ in., \_\_\_\_\_ ft.

Sand \_\_\_\_\_

Gas \_\_\_\_\_

Oil \_\_\_\_\_

Total Depth 3515

### PRODUCTION

1st 24 hrs. Nat. \_\_\_\_\_

1st 24 hrs. after shot \_\_\_\_\_

Gas \_\_\_\_\_ Cu. Ft.

Dry Hole \_\_\_\_\_

Abandoned \_\_\_\_\_

Date

FEB 24 1937

19

S. J. LEWIS

Scout