


Section 18 Township 18 Range 15-W

Well Number #1 Schnider

Company Herndon Dlg.

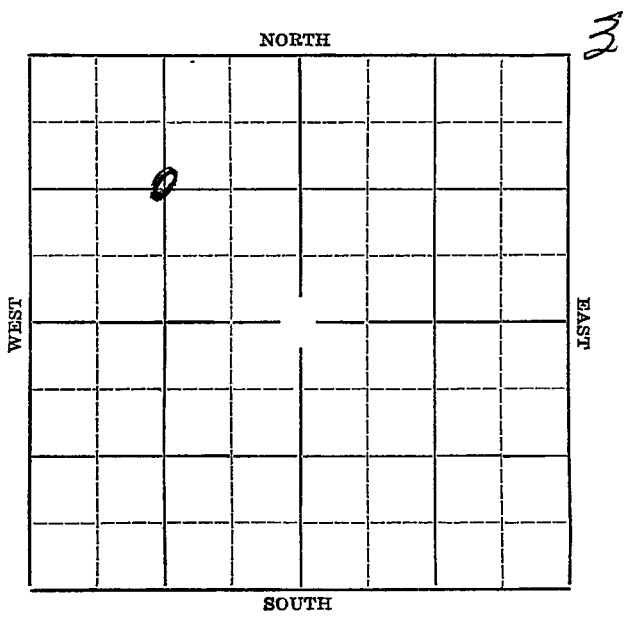

KANSAS

Map No. 73 Sec. 18 Twp. 18 R. 15WWell No. 1 SchneiderHernandez Drilling Company

Contractor

SECTION PLAT

	⊙		





FIRST REPORT

Location _____

Rig up _____

Drilling and Remarks:

ROG

RECORD

Cased _____ in., _____ ft.

Sand _____

Gas _____

Oil _____

Total Depth _____

PRODUCTION

1st 24 hrs. Nat. _____

1st 24 hrs. after shot _____

Gas _____ Cu. Ft.

Dry Hole _____

Abandoned _____

Date

NOV 4 1936 19

S. J. LEWIS Scout

Bar ton

Map No. 73 Sec. 18 Twp. 18 R. 15W

Well No. 1. Schneider

H. S. Snelson & Co. Company

J Contractor

SECTION PLAT

	⊙		

1320 Ft. from N. Line

_____ Ft. from S. Line

_____ Ft. from E. Line

1320 Ft. from W. Line

COMPLETED

Location _____

Rig up _____

Drilling and Remarks:

*Basil, Sol 3495
Granite 3569*

5 1/2 M Gas

RECORD

Cased _____ in., _____ ft.

Sand _____

Gas _____

Oil _____

Total Depth 3570

PRODUCTION

1st 24 hrs. Nat. _____

1st 24 hrs. after shot _____

Gas _____ Cu. Ft.

Dry Hole _____

Abandoned _____

Date

DEC 29 1936 19

S. J. LEWIS

Scout