


Cowley

KANSAS

Section 25 Township 31 Range 6E

Well No. #1 Foster

Company McKnab et al

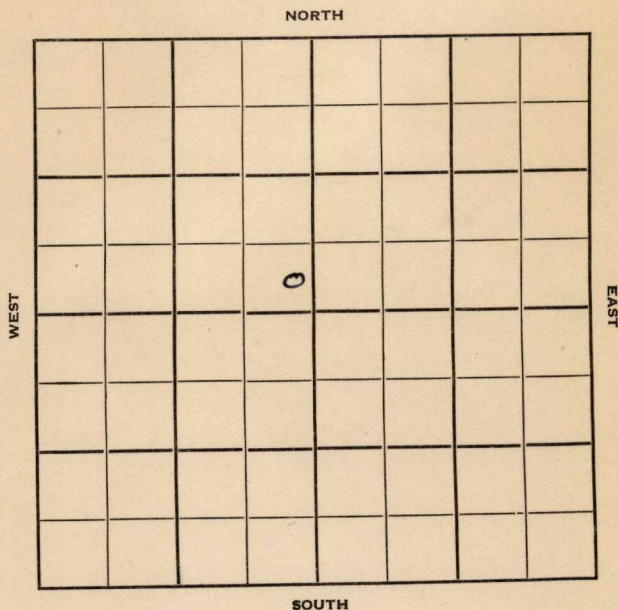

KANSAS

Cowley

Sec. 25 Twp. 31 R. 6-E ✓

Well No. #1 Foster Farm

McKnab etal Company

Jones Construction Contractor
Burden, East


 Ft. from N. Line

330 Ft. from S. Line

100 Ft. from E. Line

 Ft. from W. Line

NORTH

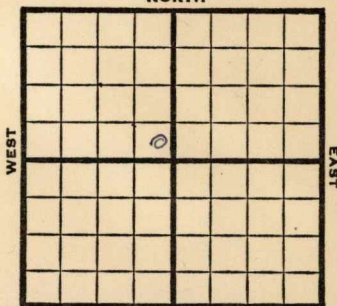

SOUTH

SE SE NW

1950

Elev 1385'

REPORT

2/1

RUR

2/15

TD 2141'

5"@ 2141'

D&A

Aband.

ABANDONED

Kansas

Burden, East

Map No. _____ Sec. 25 Twp. 31 R. 6EWell No. 1 Foster

McKnab et al.


Company

Jones Construction

Contractor

SE SE NW

SECTION PLAT

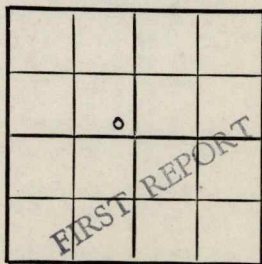

_____ Ft. from N. Line

330 Ft. from S. Line100 Ft. from E. Line

_____ Ft. from W. Line

Cowley County

Location _____

Rig up _____

Drilling and Remarks:

R U R

RECORD

Cased _____ in., _____ ft.

Sand _____

Gas _____

Oil _____

Total Depth _____

PRODUCTION

1st 24 hrs. Nat. _____

1st 24 hrs. after shot _____

Gas _____ Cu. Ft.

Dry Hole _____

Abandoned _____

Date

FEB 1 1950

19

J. E. TYRA

Scout

Kansas

Map No. _____ Sec. 25 Twp. 31 R. 36EWell No. 1 Foster

_____ McKnab etal. _____ Company

Contractor

SE SE NW

E1. 1385

SECTION PLAT



_____ Ft. from N. Line

330 Ft. from S. Line100 Ft. from E. Line

_____ Ft. from W. Line

Cowley County

RECORD

Location _____

Cased _____ in., _____ ft.

Rig up _____

Sand _____

Drilling and Remarks:

Gas _____

5" @ 2141

Oil _____

T.D. 2141

Total Depth _____

D & A.

PRODUCTION

1st 24 hrs. Nat. _____

1st 24 hrs. after shot _____

Gas _____ Cu. Ft.

Dry Hole _____

Abandoned _____

Date

FEB 15 1950

J. E. TYRA

19

Scout