


Map No. KANSAS Sec. 25 Twp. 30 R. 10

Well No. 1-Ben Farm
M. L. Truby Company

NORTH

WEST

EAST

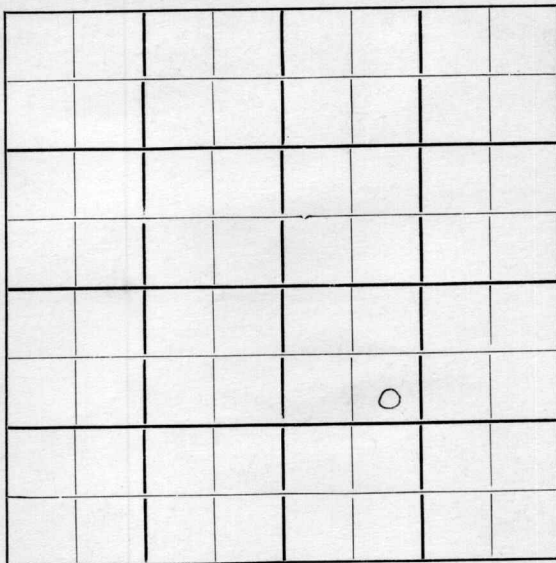

SOUTH

Location.....

Drilling Remarks

.....

.....

.....

.....

.....

.....

.....

.....

.....

.....

Rig Up.....

Drilling Remarks

.....

.....

.....

.....

.....

.....

.....

.....

.....

.....

RECORD

Cased..... in..... ft.

Sand.....

Gas.....

Oil.....

Total Depth.....

PRODUCTION

1st 24 hrs. Nat.....

1st 24 hrs. after shot.....

Gas..... cu. ft.....

Dry Hole.....

Abandoned.....

Map No. KANSAS Sec. 25 Twp. 30 R. 10

Well No. 1- Ben Farm


M. J. Truby Company

1070 Ft. from N. Line

..... Ft. from S. Line

..... Ft. from E. Line

1070 Ft. from W. Line

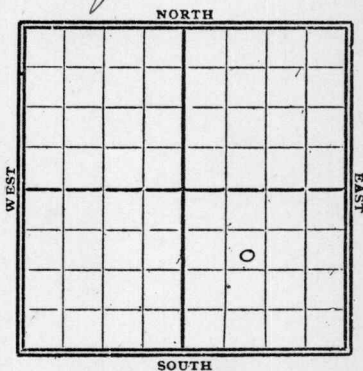

1929

Date

REPORT

1/2	Rigging up
1/9	Spudded & 50'
1/16	Spdgy.
1/23	" 290'
1/30	Drlg 450'
2/6	fsq 710'
2/13	
2/20	drlg 1297'
2/27	" 1572'
3/6	Oswego 1602-21'
	ITD. 1627'
	Dry & Abandoned

Map No. K9 Sec. 25 Twp. 30 R. 10
 Well No. M. L. Turkey

Company

Contractor

FIRST REPORTS

SECTION PLAT

1070 Ft. from N. Line

Ft. from S. Line

Ft. from E. Line

1070 Ft. from W. Line

Location

Rig up

Drilling and Remarks:

RECORD

Cased.....in.,ft.

Sand.....

Gas.....

Oil.....

Total Depth.....

PRODUCTION

1st 24 hrs. Nat.....

1st 24 hrs. after shot.....

Gas.....Cu. Ft.

Dry Hole.....

Abandoned.....

Date

CHAS. L. SHERWOOD

JAN 2 1929

192..... Scout

Map No. 9 KANSAS Sec. 75 Twp. 30 R. 10
 Well No. 1
M. L. Truby Company
 Contractor

COMPLETE

SECTION PLAT

1070 Ft. from N. Line
 Ft. from S. Line
 Ft. from E. Line
1070 Ft. from W. Line

ABANDONED

Location

Rig up

Drilling and Remarks:

Drulego 1602-1621

DDr 1627

RECORD

Cased in., ft.

Sand

Gas

Oil

Total Depth 1627

PRODUCTION

1st 24 hrs. Nat.

1st 24 hrs. after shot

Gas Cu. Ft.

Dry Hole ☒

Abandoned ☒

Date

MAR 6 1929

192 CHAS. L. SHERWOOD Scout