

DX 78-1


Cowley

KANSAS

Section 25 Township 31 Range 6E

Well No. #5 Foster

Company B.M.D. Management

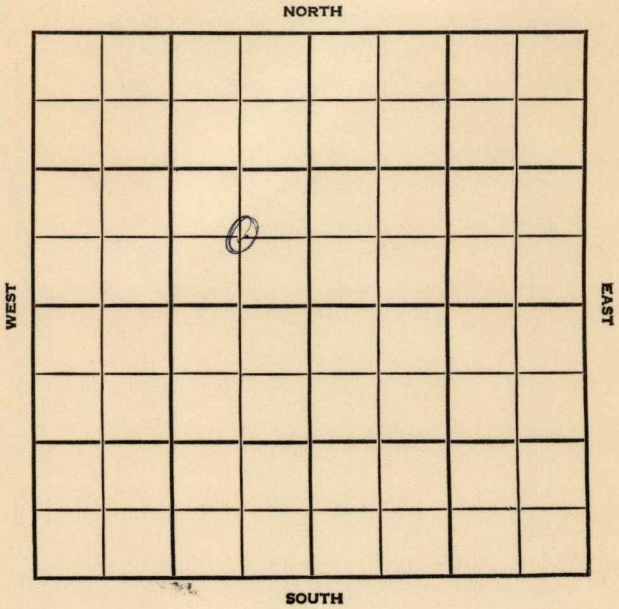

County Cowley Elev. _____
 Sec. 25 Twp. 31 Rge. 6E
 Company B.M.D. Management
 Farm Name Foster No. 5

TOPS	DEPTH	LOG	DATUM	Loc. in Sec.
Anh.				C SE NW
Tp.				
H.				
Tr.				
Dg.				
Bl.				
L.				Geol. _____
K.C.				Contr. _____
B.K.C.				Crisswell Tools
Ce.				
C.				Pool
M.				Mansur
M.				
K.				
Mz.				
Me.				
V.				
S.				
S.				
A				
R.				
PE.				
G.				
T.D.				

NOV 21 1956
 FIRST REPORT

Date Comm. spd. 11-16-56
surf set @ @?, Drlg. 2150

26

Co.
 No.
 Sec.
 T.
 R.

County Cowley Elev. 1406
 Sec. 25 Twp. 31 Rge. 6E
 Company B.M.D. Management (Beamer-Miller & Davis)
 Farm Name Foster No. 5

TOPS	DEPTH	LOG	DATUM	Loc. in Sec.
Anh.				C SE NW
Tp. <u>HOOV</u>	<u>1551-57</u>			
H. <u>stall</u>	<u>1719</u>			
Tr.				
Dg.				
Bl.				
L. <u>1945</u>				Geol.
K.C. <u>Loyt</u>	<u>2194</u>			Contr.
B.K.C.				Crisswell Too
Ce.				
C.				Pool
M.				Mansur
M.				
K.				
Mz.				
Ma.				
V.				
S.				
S.				
A.				
R.				
PE.				
G.				
TD.	<u>2203</u>			

DEC 20 '56
 ○
COMPLETE

Date Comm. spd. 11-16-56
 surf set 24?, Drlg. 2150 NOV 28 '56

5 1/2 2202/75 BB 2209 Fiac
5x5 8 50 B0 + wtr 16 hrs
 DEC 5 '56 P. 35 B0 pd + wtr DEC 12 '56
 DEC 19 '56 P. 20 B0 pd + wtr