


Elk.

Map No. *15* Sec. *25* Twp. *30* R. *10*

Well No. *1 - Sigher* Farm
Pennock Oil Company

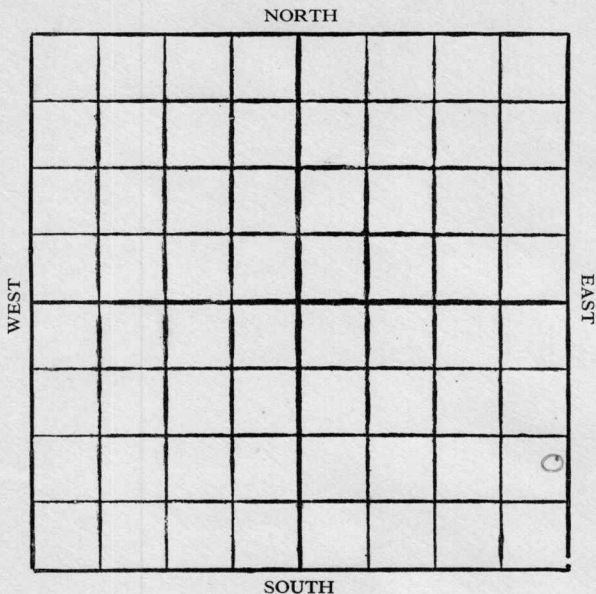

Location

Drilling Remarks

Rig Up

Drilling Remarks

RECORD

Cased in. ft.

Sand

Gas

Oil

Total Depth

PRODUCTION

1st 24 hrs. Nat.

1st 24 hrs. after shot

Gas cu. ft.

Dry Hole


Abandoned

ELK

Map No. Kansas Sec. 25 Twp. 30 R 10

Well No. 1 Sigler Farm
Pennock oil Company

_____ Ft. from N. Line
1120 Ft. from S. Line
200 Ft. from E. Line
_____ Ft. from W. Line

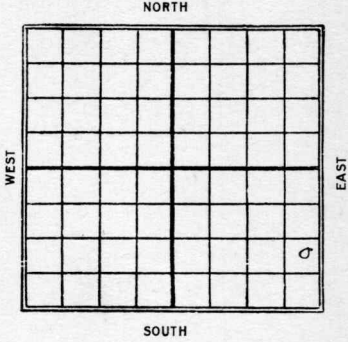

Date
1927
1/8

REPORT

Abandoned 1200

9 KANSAS 25 30 10
 Map No. _____ Sec. _____ Twp. _____ R. _____

Well No. 1

 Pennocis oil Co. _____ Company

_____ Contractor

FIRST REPORTS

_____ Ft. from N. Line

1120 _____ Ft. from S. Line

200 _____ Ft. from E. Line

_____ Ft. from W. Line

COMPLETED

SECTION PLAT

ABANDONED			
			o

Location _____

Rig up _____

Drilling and Remarks:

RECORD

Cased _____ in., _____ ft.

Sand _____

Gas _____

Oil _____

Total Depth 1200 _____

PRODUCTION

1st 24 hrs. Nat. _____

1st 24 hrs. after shot _____

Gas _____ Cu. Ft.

Dry Hole ✓ _____

Abandoned ✓ _____

Date

JAN 8 1927

192 _____ Scout

CHAS. L. SHERWOOD