


Section 15 Township ~~24~~ 30 Range 10-E

Well Number 1 - Zimmerman

Company G. T. Berry

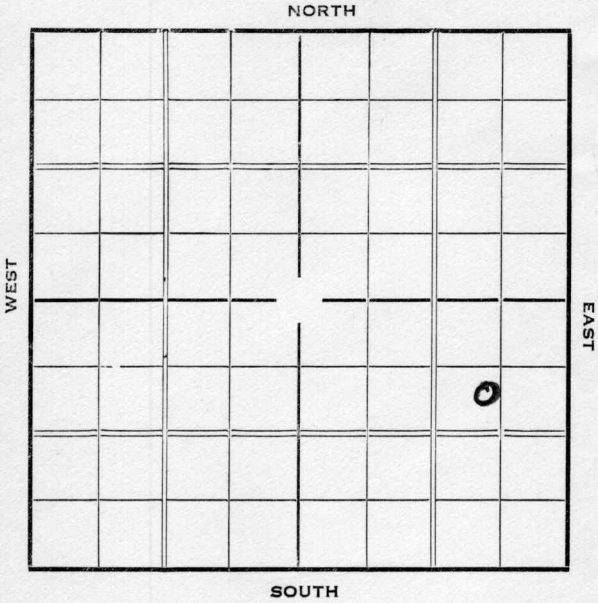

Sec. 15 Twp. ~~34~~ 30 R. 10-E


Well No. #1 Zimmerman Farm
G. T. Berry Company

920 Ft. from N. Line

_____ Ft. from S. Line

700 Ft. from E. Line

_____ Ft. from W. Line

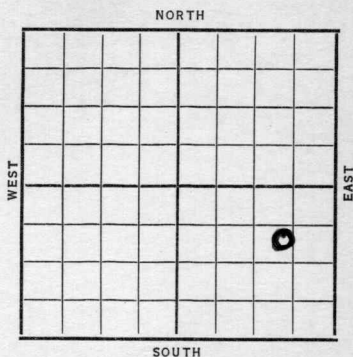

Date	REPORT
1937	
5/19	Drlg. 375'.
6/23	Miss. 2001'.
	T.D. 2031'.
	ABANDONED

Elk

KANSAS

Map No. 1 Sec. 15 Twp. 34 R. 10^E

Well No. 1 - Zimmerman

G. F. Berry Company
Contractor

FIRST REPORT

SECTION PLAT

920 Ft. from N. Line

_____ Ft. from S. Line

700 Ft. from E. Line

_____ Ft. from W. Line

			0

Location _____

Rig up _____

Drilling and Remarks:

Dig-375

RECORD

Cased _____ in., _____ ft.

Sand _____

Gas _____

Oil _____

Total Depth _____

PRODUCTION

1st 24 hrs. Nat. _____

1st 24 hrs. after shot _____

Gas _____ Cu. Ft.

Dry Hole _____

Abandoned _____

Date

MAY 19 1937

H. D. Hatfield

19

Scout

Elk

KANSAS

Map No. 9 Sec. 15 Twp. 30 R. 10 ^E

Well No. 1 - Zimmerman

G. F. Berry Company

Contractor

CORRECTION

920 Ft. from N. Line

_____ Ft. from S. Line

700 Ft. from E. Line

_____ Ft. from W. Line

SECTION PLAT

			0

Location _____

Rig up _____

Drilling and Remarks:

*First reported
as township 34*

RECORD

Cased _____ in., _____ ft.

Sand _____

Gas _____

Oil _____

Total Depth _____

PRODUCTION

1st 24 hrs. Nat. _____

1st 24 hrs. after shot _____

Gas _____ Cu. Ft.

Dry Hole _____

Abandoned _____

Date

JUN 30 1937 19

H. D. Hatfield

Scout

Elk KANSAS

Map No. _____ Sec. 15 Twp. 30 R. 10 E

Well No. 1 - Zimmerman

H. T. Berry Company
Contractor

ABANDONED

SECTION PLAT

920 Ft. from N. Line
_____ Ft. from S. Line
700 Ft. from E. Line
_____ Ft. from W. Line

			0
			0

Location _____

Rig up _____

Drilling and Remarks:

DXA

RECORD

Cased _____ in., _____ ft.
Sand MISS 200
Gas _____
Oil _____
Total Depth 2031

PRODUCTION

1st 24 hrs. Nat. _____
1st 24 hrs. after shot _____
Gas _____ Cu. Ft.
Dry Hole _____
Abandoned _____

Date

JUN 23 1937 19


H. D. Hatfield Scout

First Report shows Twp. 34

Your first report township 34
Check and advise
Sam



ABANDONED
From N. line
From N. line
From E. line
From W. line

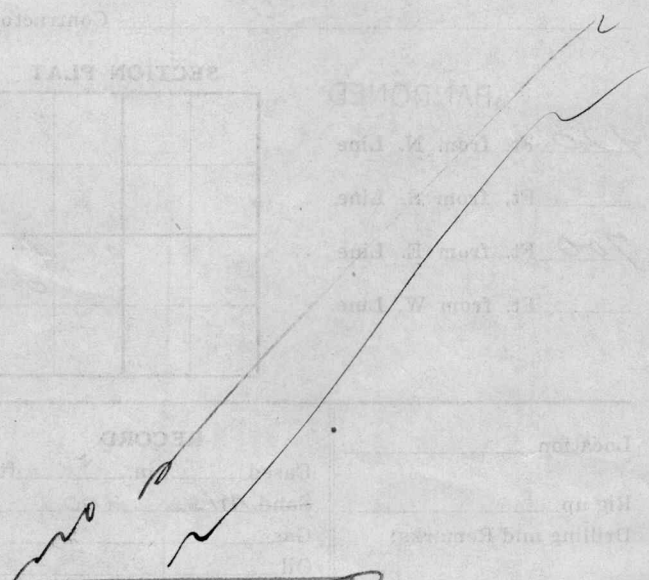

Returned	
Cards	<i>Paul</i>
Tracing	<i>Jms</i>
France Map	<i>Jms</i>
Scarborough Map	<i>W. H. H.</i>
Moody Map	
Scarborough Plat Book	
Moody Plat Book	