


Form 51—5M—7-39—Palace

Section 19 Township 18 Range 15W

Well No. #1 Bahr

Company Ohio et al

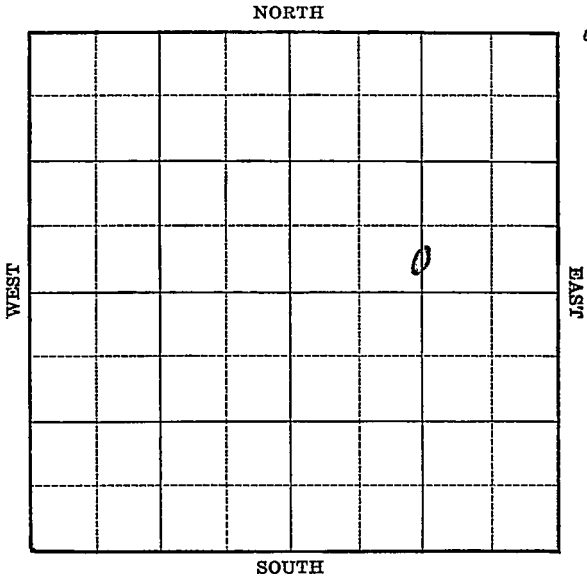

Map No. _____ Sec. 19 Twp. 18 R. 15^W

Well No. 1 Bahr

Ohio etal

Company

Contractor

FIRST REPORT

SECTION PLAT

C S L N E

_____ Ft. from N. Line

330 Ft. from S. Line

1320 Ft. from E. Line

_____ Ft. from W. Line

ALBERT POOL

Location _____

Rig up _____

Drilling and Remarks:

Anhy. 934

8" - 940

WOC

RECORD

Cased _____ in., _____ ft.

Sand _____

Gas _____

Oil _____

Total Depth _____

PRODUCTION

1st 24 hrs. Nat. _____

1st 24 hrs. after shot _____

Gas _____ Cus Ft.

Dry Hole _____

Abandoned _____

Date

JUL 17 1940 19

S. J. LEWIS Scout

Map No. _____ Sec. 19 Twp. 18 R. 15W

Well No. 1 Bahr

Ohio etal Company

Contractor

COMPLETE

C S L N E

_____ Ft. from N. Line

330 Ft. from S. Line

1320 Ft. from E. Line

_____ Ft. from W. Line

ALBERT POOL

SECTION PLAT

Location _____

Rig up _____

Drilling and Remarks:

Reagan 3483
5" C 3473

6,833,000 Gas

RECORD

Cased _____ in., _____ ft.

Sand _____

Gas _____

Oil _____

Total Depth 3509

PRODUCTION

1st 24 hrs. Nat. _____

1st 24 hrs. after shot _____

Gas _____ Cu. Ft.

Dry Hole _____

Abandoned _____

Date

AUG 14 1940 19

S. J. LEWIS Scout