

KANSAS


Barton

Form 51-5M-7-39-Palace

Section 21 Township 18 Range 15-W

Well No. #1 Brack

Company Ohio Oil Albert Pool

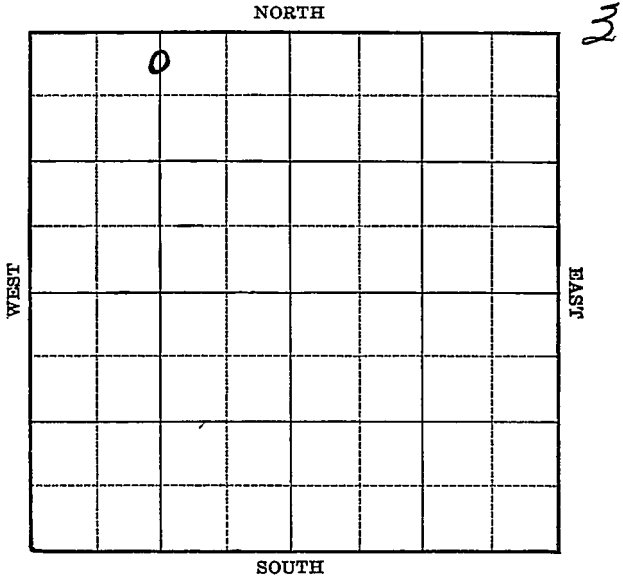

Map No. 73 Sec. 21 Twp. 18 R. 15WWell No. 1 BrackOhio Oil


Company

Contractor

FIRST REPORT**C N L NW**330 Ft. from N. Line

_____ Ft. from S. Line

_____ Ft. from E. Line

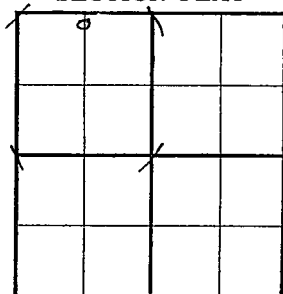1320 Ft. from W. Line**ALBERT POOL****SECTION PLAT**

Location _____

Rig up _____

Drilling and Remarks:

Rotary S.H.**RECORD**

Cased _____ in., _____ ft.

Sand _____

Gas _____

Oil _____

Total Depth _____

PRODUCTION

1st 24 hrs. Nat. _____

1st 24 hrs. after shot _____

Gas _____ Cu. Ft.

Dry Hole _____

Abandoned _____

Date

MAR 20 1940

19

S. J. LEWIS Scout

Map No. 73 Sec. 21 Twp. 18 R. 15W

Well No. 1 Brack

Ohio Oil Company

Contractor

COMPLETED

C N L NW

SECTION PLAT

330 Ft. from N. Line

_____ Ft. from S. Line

_____ Ft. from E. Line

1320 Ft. from W. Line

o			

ALBERT POOL

Location _____

RECORD

Rig up _____

Cased _____ in., _____ ft.

Drilling and Remarks:

Sand _____

Reagan 3467
5" 3470

Gas _____

Oil _____

Total Depth 3514

18,900,000 Gas

PRODUCTION

1st 24 hrs. Nat. _____

1st 24 hrs. after shot _____

Gas _____ Cu. Ft.

Dry Hole _____

Abandoned _____

Date

MAY 8 1940 19

S. J. LEWIS Scout