

KANSAS


Barton

FORM 51 5M 1-42 PETROL

Section 26 Township 18 Range 15-W

Well No. #1 Bahr

Company Gulf et al
Shirley Glum

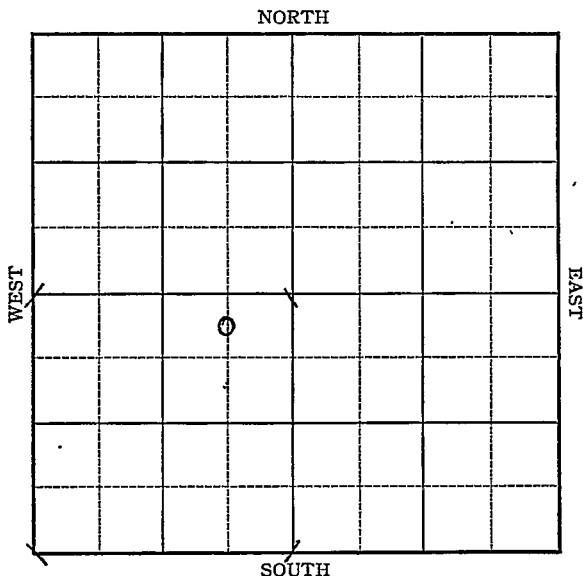

KANSAS

Barton

Sec. 26 Twp. 18 R. 15-W

Well No. #1 Bahr Farm

Gulf et al
Shirley Glum Company

Wildcat


330 Ft. from N. Line

 Ft. from S. Line

660 Ft. from E. Line

 Ft. from W. Line

Elev. 1917

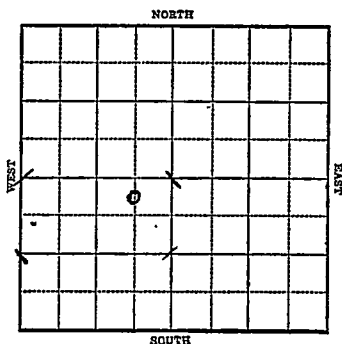

1943

R E P O R T

6/2	Location.
6/9	"
6/16	"
6/23	"
6/30	"
7/7	"
7/15	Annly 876 13" @ 120' 8" @ 896 Topeka 2935 Lans 3195 Drlg. 3308'
7/21	CONG 3443 Baral sd 3470 T.D. 3485 5" @ 3468' RUST
7/28	T.D. 3506 T.D. flowed 6 oil per hr.
8/4	" " " "
8/11	" " " "
8/18	" " " "
8/25	" " " "

OVER

1943

9/1 TD flow 6 oil per hr.

9/8 " " " " "

9/15 " " " " "

9/22 " " " " "

9/29 Basal Sd 3470

5" @ 3468

Pump 50 Pot.

Gravity 37.3

T.D. 3506'

COMPLETED

Barton

Map No. ~~KANSAS~~ Sec. 26 Twp. 18 R. 15W

Well No. 1 Bahr

Shirley Clum Company

FIRST REPORT Contractor

C NL NE SW


SECTION PLAT

330 Ft. from N. Line

Ft. from S. Line

660 Ft. from E. Line

Ft. from W. Line

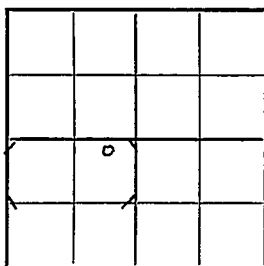

WILDCAT

Location XXX

Rig up

Drilling and Remarks:

RECORD

Cased in, ft.

Sand

Gas

Oil

Total Depth

PRODUCTION

1st 24 hrs. Nat.

1st 24 hrs. after shot

Gas Cu. Ft.

Dry Hole

Abandoned

Date

JUN 2 1943 19


S. J. LEWIS Scout

Map No. 73 ^{KANSAS} Sec. 26 Twp. 18 R. 15W
 Well No. 1 Bahr

Gulf et al. Company
CORRECTION Contractor

C N L NE SW

SECTION PLAT

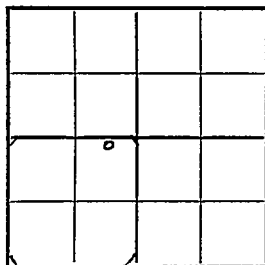330 Ft. from N. Line Ft. from S. Line660 Ft. from E. Line Ft. from W. LineBahr PoolLocation Rig up

Drilling and Remarks:

Gulf has taken
 this over from
 Shirley Clum

RECORD

Cased in., ft.Sand Gas Oil Total Depth

PRODUCTION

1st 24 hrs. Nat. 1st 24 hrs. after shot Gas Cu. Ft.Dry Hole Abandoned

Date

SEP 8 1943 19S. J. LEWIS Scout

KANSAS

Map No. 3 Sec. 26 Twp. 18 R. 15WWell No. 1 BahrGulf et al. CompanyCOMPLETED Contractor

C N L NE SW

330 Ft. from N. Line Ft. from S. Line660 Ft. from E. Line Ft. from W. Line

SECTION PLAT

	0		

Bahr PoolLocation SERig up

Drilling and Remarks:

Basal G 134705' 10 34 68'Pump 50 Bk.37 3/4

RECORD

Cased in., ft.Sand Gas Oil Total Depth 3506

PRODUCTION

1st 24 hrs. Nat. 1st 24 hrs. after shot Gas Cu. Ft.Dry Hole Abandoned

Date

SEP 29 1943 19S. J. LEWIS Scout