

KANSAS


Form 51-5M-7-40-Palace

Barton

Section 27 Township 18 Range 15-W

Well No. #1 Skolant

Company Hannum Drilling et al

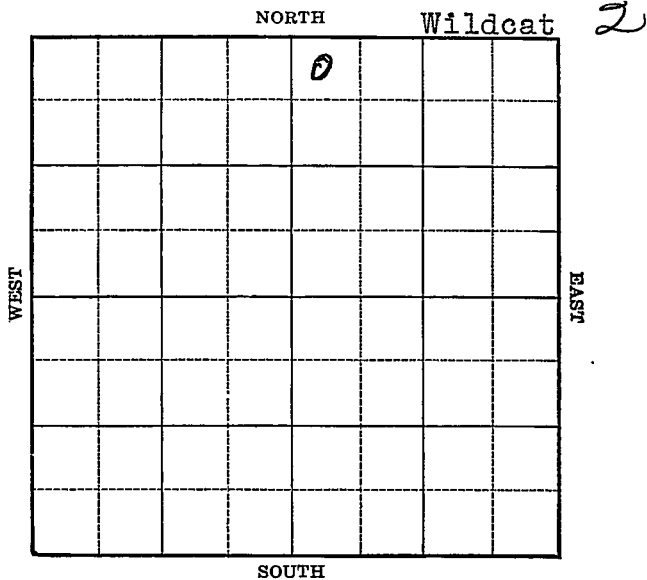

Map No. 73 Sec. 27 Twp. 18 R. 15W

Well No. 1 Skolant

Hannum Drilling etal Company

Contractor

COMPLETED

SECTION PLAT

NW NE

		0	

330 Ft. from N. Line

_____ Ft. from S. Line

_____ Ft. from E. Line

330 Ft. from W. Line

WILDCAT

Location _____

Rig up _____

Drilling and Remarks:

Basal. 2445.

5" 3449

23M Gas

RECORD

Cased _____ in., _____ ft.

Sand _____

Gas _____

Oil _____

Total Depth 3500

PRODUCTION

1st 24 hrs. Nat. _____

1st 24 hrs. after shot _____

Gas _____ Cu. Ft.

Dry Hole _____

Abandoned _____

Date

JAN 22 1941 19

S I LEWIS Scout