

KANSAS


Cowley

Section 25 Township 31 Range 6E

Well No. 1 Mansur *(Manser)*

Company G.T. Lecky

Wildcat
NORTH

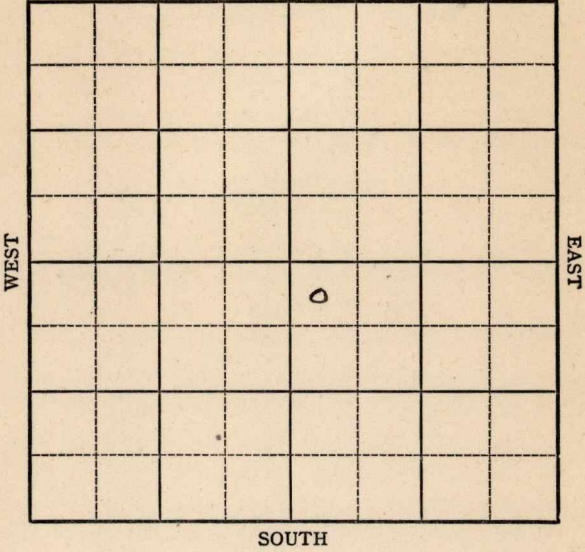

KANSAS Cowley

Sec. 25 Twp. 31 R. 6E

Well No. #1 Mansur Farm

G. T. Lacky Company


Wildcat

330' Ft. from N. Line

_____ Ft. from S. Line

_____ Ft. from E. Line

330' Ft. from W. Line

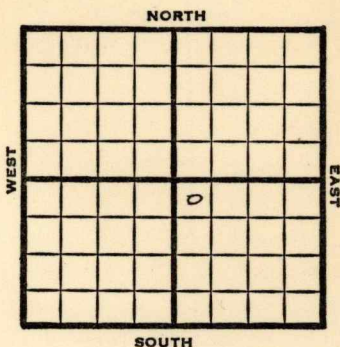

NW SE

1949 **Elev. 1386'** REPORT

- 6/1 Location
- 6/7 15" @ 300'
Drlg 690'
- 6/15 13" @ 896'
10" @ 1475'
Drlg. 1510'
- 6/21 8" @ 1838'
Drlg. 2025'
- 6/28 Drlg. 2132'
- 7/6 **Layton 2170'**
TD 2182
7" @ 2170'
400' oil
- 7/12 "
- 7/20 "
- 7/27 "
- 8/3 "
- 8/10 "
- 8/17 "
- 8/24 "
- 8/31 **KC 2470'**
Mississippi 2817'
TD 2817'

OVER

1949

9/7 Miss 2812'
7" @ 2170'
Acid 2000
Gas 1,180,000
TD 2917'

COMPLETED

Map No. _____ Sec. 25 Twp. 31 R. 6E

Well No. 1 Mansur

G. T. Lacky Company

Contractor

NW SE

**FIRST REPORT
SECTION PLAT**

330 Ft. from N. Line

_____ Ft. from S. Line

_____ Ft. from E. Line

330 Ft. from W. Line

		o	

Cowley County

Location X

Rig up _____

Drilling and Remarks:

RECORD

Cased _____ in., _____ ft.

Sand _____

Gas _____

Oil _____

Total Depth _____

PRODUCTION

1st 24 hrs. Nat. _____

1st 24 hrs. after shot _____

Gas _____ Cu. Ft.

Dry Hole _____

Abandoned _____

Date

JUN 1 1949 19

S. J. LEWIS

Scout

Map No. K2 Sec. 25 Twp. 31 R. 6E

Well No. 1 Mansur

G. T. Lucky Company

COMPLETE

Contractor

NW SE

E 1,138 1/2
SECTION PLAT

330 Ft. from N. Line

_____ Ft. from S. Line

_____ Ft. from E. Line

330 Ft. from W. Line

		o	

Cowley County

Location _____

Rig up _____

Drilling and Remarks:

Miss 2812
7" @ 2170
2000 cu ft
1,180,000 Gal

RECORD

Cased _____ in., _____ ft.

Sand _____

Gas _____

Oil _____

Total Depth 2917

PRODUCTION

1st 24 hrs. Nat. _____

1st 24 hrs. after shot _____

Gas _____ Cu. Ft.

Dry Hole _____

Abandoned _____

Date

SEP 7 1949 19

S. J. LEWIS Scout