

Map No. 61k KANSAS Sec. 27 Twp. 30 34 R. 10
 Well No. 1-Schulz Farm
Torrey & Small Company

NORTH

				o			

WEST

EAST

SOUTH

Location.....

Drilling Remarks

.....

.....

RECORD

Cased..... in..... ft.

Sand.....

Gas.....

Oil.....

Total Depth.....

Rig Up.....

Drilling Remarks

.....

.....

PRODUCTION

1st 24 hrs. Nat.....

1st 24 hrs. after shot.....

Gas..... cu. ft.....

Dry Hole.....

Abandoned.....


Map No. KANSAS Sec. 27 Twp. 30 R. 10
 Well No. 1 - Schul Farm
Torrey & Small Company

250 Ft. from N. Line

_____ Ft. from S. Line

_____ Ft. from E. Line

250 Ft. from W. Line

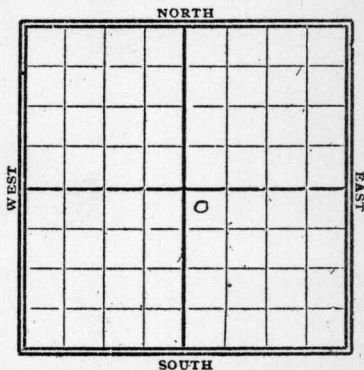

1928

Date	REPORT
12/12	P.U. Machine
12/19	S.D. at 240'
12/26	—
1929	
1/2	drlg 600'
1/9	S.D. 600'
1/16	drlg 890'
1/23	" 1050'
1/30	S.D. 1200' for casing
2/6	drlg 1600'
2/13	" 1600'
2/20	S.D. 1600'
2/27	—
3/6	—
3/13	S.D. 1720'
3/20	— 5/8 —
3/27	— 5/15 —
4/3	— 5/22- drlg 1750'
4/10	— 5/29- S.D. 2093'
4/17	— 6/5- T.D. 2093'
4/24	— Abandoned
5/1	—

Map No. **KANSAS** Sec. **27** Twp. **31** R. **10**

Well No. **1** **Schul**

Torrey & Small Company

Contractor

FIRST REPORTS

250 Ft. from N. Line

Ft. from S. Line

Ft. from E. Line

250 Ft. from W. Line

SECTION PLAT

		o	

Location

Rig up

Drilling and Remarks:

lv. machine.

RECORD

Cased in., ft.

Sand

Gas

Oil

Total Depth

PRODUCTION

1st 24 hrs. Nat.

1st 24 hrs. after shot

Gas Cu. Ft.

Dry Hole

Abandoned

Date

DEC 12 1928

CHAS. L. SHERWOOD

192 Scout

Map No. KANSAS Sec. 27 Twp. 30 R. 10
 Well No. 1 Schub
Jarvey & Small Company

Contractor

CORRECTION

750 Ft. from N. Line
 _____ Ft. from S. Line
 _____ Ft. from E. Line
750 Ft. from W. Line

SECTION PLAT

		0	

Location _____

Rig up 5/0 740

Drilling and Remarks:

Pres Reported
in Sep 31.

Chy to Sep 30.

RECORD

Cased _____ in., _____ ft.
 Sand _____
 Gas _____
 Oil _____
 Total Depth _____

PRODUCTION

1st 24 hrs. Nat. _____
 1st 24 hrs. after shot _____
 Gas _____ Cu. Ft.
 Dry Hole _____
 Abandoned _____

Date

DEC 19 1928

CHAS. L. SHERWOOD

192

Scout

Elk

Map No. KANSAS Sec. 27 Twp. 30 R. 10

Well No. 1 Schul

Torrey & Small Company

Contractor

COMPLETE

SECTION PLAT

750 Ft. from N. Line

Ft. from S. Line

Ft. from E. Line

750 Ft. from W. Line

		0	

ABANDONED

Location

Rig up

Drilling and Remarks:

RECORD

Cased.....in.,ft.

Sand.....

Gas.....

Oil.....

Total Depth 2093

PRODUCTION

1st 24 hrs. Nat.....

1st 24 hrs. after shot.....

Gas.....Cu. Ft.

Dry Hole ☒

Abandoned ☒

Date

JUN 5 1929

CHAS. L. SHERWOOD

192.....Scout