

KANSAS
KANSAS


FORM 51 5M 11-44 PETROL

Barton County

Section 12 Township 20 Range 12W

Well No. #4 Schartz "C"

Company EE E. Ash

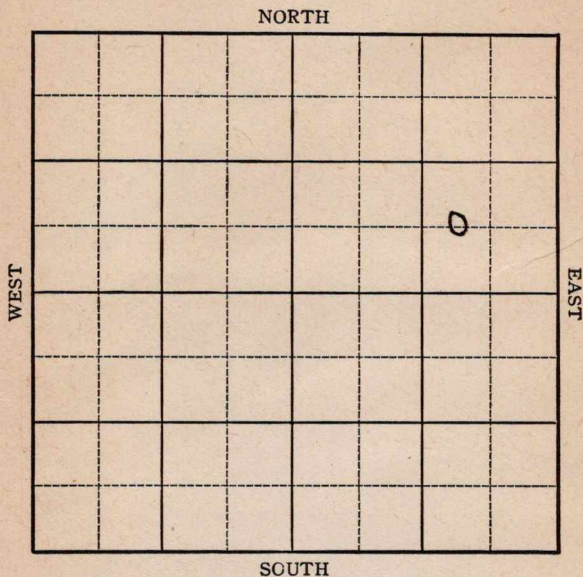

KANSAS

Barton

Sec. 12 Twp. 20 R. 12-W

Well No. #4 Schartz "C" Farm

E. E. Ash Company

Ft. from N. Line

660


Ft. from S. Line

990

Ft. from E. Line

Ft. from W. Line

NORTH

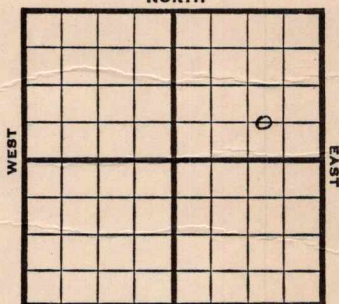

SOUTH

C WL SE N E

1946 REPORT

Elev. 1788

6/12

8" @ 330'

Waiting on cement.

6/19

Anhy 550

Drlg 2682'

6/26

Lans 3086

Arb 3323

TD 3332

5" @ 3328 RUST

7/3

" "

7/9

" "

7/16

" "

7/23

" "

7/30

TD 3349-3000 acid

8/6

Drlg 3351

8/13

TD 3351, SD

8/20

" "

8/27

" "

9/5

" "

9/10

" "

9/18

" "

9/24

" "

10/1

" "

10/8

" "

10/15

" "

10/22

" "

10/29

" "

11/6

" "

OVER

1946

741736

11/12 SDO

11/20 "

11/27 "

12/3 "

12/10 "

12/17 "

1947

1/4 TD SLO

1/8 "

1/15 Arb 3323'
5" @ 3328'
TD 3356'
Pump 125 Pot
Grav. 41.7

COMPLETED

Kansas Pool Name Ellinwood

KANSAS
 Map No. 46 Sec. 12 Twp. 20 R. 12W

Well No. 4 Schartz "C"

E. E. Ash

Company

CORRECTION

Contractor

C W L SE NE

SECTION PLAT

			◊

Ft. from N. Line

660

Ft. from S. Line

990

Ft. from E. Line

Ft. from W. Line

Barton County

Location

Rig up

Drilling and Remarks:

Had foot

Measurements

Wrong.

RECORD

Cased _____ in., _____ ft.

Sand _____

Gas _____

Oil _____

Total Depth _____

PRODUCTION

1st 24 hrs. Nat. _____

1st 24 hrs. after shot _____

Gas _____ Cu. Ft.

Dry Hole _____

Abandoned _____

Date

JUN 19 1946

19

S. J. LEWIS

Scout

KANSAS Kansas Pool Name EllinwoodMap No. _____ Sec. 12 Twp. 20 R. 12WWell No. 4 Schartz "C"C. E. Ash Company**FIRST REPORT**

Contractor

C W L SE NE

SECTION PLAT

			0

_____ Ft. from N. Line

660 Ft. from S. Line990 Ft. from E. Line990 Ft. from W. LineBarton County *check*

Location _____

Rig up _____

Drilling and Remarks:

8" @ 330 WOC**RECORD**

Cased _____ in., _____ ft.

Sand _____

Gas _____

Oil _____

Total Depth _____

PRODUCTION

1st 24 hrs. Nat. _____

1st 24 hrs. after shot _____

Gas _____ Cu. Ft.

Dry Hole _____

Abandoned _____

Date

JUN 12 1946

19

S. J. LEWIS

Scout

Kansas **KANSAS**Map No. 46 Sec. 12 Twp. 20 R. 12WWell No. 4 Scharzt "C"C. E. Ash CompanyCOMPLETE ContractorC W L S E N EEl. 1788.**SECTION PLAT**

			0

 Ft. from N. Line660 Ft. from S. Line990 Ft. from E. Line Ft. from W. LineBarton CountyLocation Rig up

Drilling and Remarks:

22433285' 23328.Pump 125 Bx412 94**RECORD**Cased in., ft.Sand Gas Oil Total Depth 3306**PRODUCTION**1st 24 hrs. Nat. 1st 24 hrs. after shot Gas Cu. Ft.Dry Hole Abandoned

Date

JAN 15 194719S. J. LEWISScout