


Section 28 Township 18 Range 15-W

Well Number #1 Cook

Company Helmerick & Payne

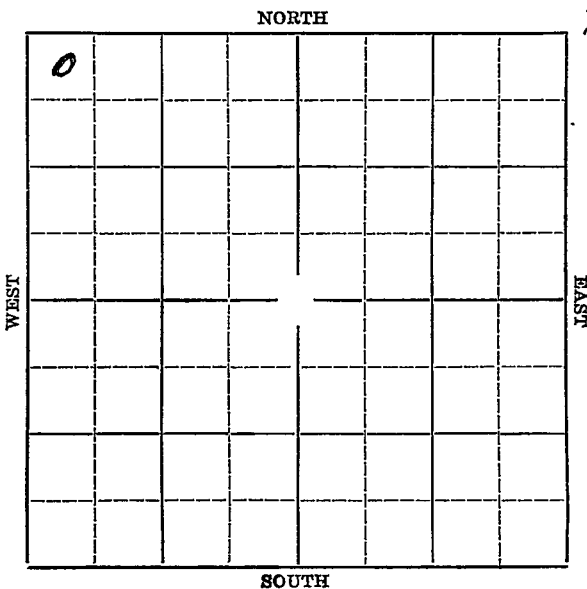


KANSAS Barton

Sec. 28 Twp. 18 R. 15-W

Well No. 1 Cook Farm

Helmerick & Payne Company

NORTH

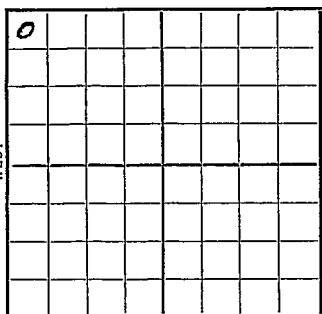

330 Ft. from N. Line

_____ Ft. from S. Line

_____ Ft. from E. Line

330 Ft. from W. Line

SOUTH

Elev. 1910

~~1936~~

REPORT

11/4 Location

11/12 Building rig.

11/19 Rig

11/27 Rigging up

12/3 Shut down.

12/10 15" @ 150'. WOC.

12/17 Drlg. 2370'.

12/24 Drlg. 3110'.

~~12/29~~ Topeka 2890'. Drlg. 3185'.

1937

1/7 6" @ 3480'. Sand 3481'.

Drlg. 3482'.

1/13 Sand 3481'. T. D. 3497'.

27 M gas.

COMPLETED

Map No. 73 Sec. 28 Twp. 18 R. 15W

Well No. 1 Cook

Helmerick & Payne Company

Contractor

SECTION PLAT

0			

330 Ft. from N. Line

_____ Ft. from S. Line

_____ Ft. from E. Line

880 Ft. from W. Line

FIRST REPORT

Location ✓

Rig up _____

Drilling and Remarks:

RECORD

Cased _____ in., _____ ft.

Sand _____

Gas _____

Oil _____

Total Depth _____

PRODUCTION

1st 24 hrs. Nat. _____

1st 24 hrs. after shot _____

Gas _____ Cu. Ft.

Dry Hole _____

Abandoned _____

Date

NOV 4 1936

19

S. J. LEWIS

Scout

~~Form 26 1M Bks. 2-29~~ **KANSAS**

Map No. 73 Sec. 28 Twp. 18 R. 15W

Well No. 1 Cook

H. L. Linnick & Payne Company

Contractor

SECTION PLAT

6			

330 Ft. from N. Line

_____ Ft. from S. Line

_____ Ft. from E. Line

330 Ft. from W. Line

COMPLETED

Location _____

Rig up _____

Drilling and Remarks:

Land 3481

27 M Gas

RECORD

Cased _____ in., _____ ft.

Sand _____

Gas _____

Oil _____

Total Depth 3497

PRODUCTION

1st 24 hrs. Nat. _____

1st 24 hrs. after shot _____

Gas _____ Cu. Ft.

Dry Hole _____

Abandoned _____

Date

JAN 13 1937 19

S. J. LEWIS Scout