


Map No. Ks Sec. 31 Twp. 30 R. 10 E
Well No. 1-Cummings Farm
L.T.I. Oil Company

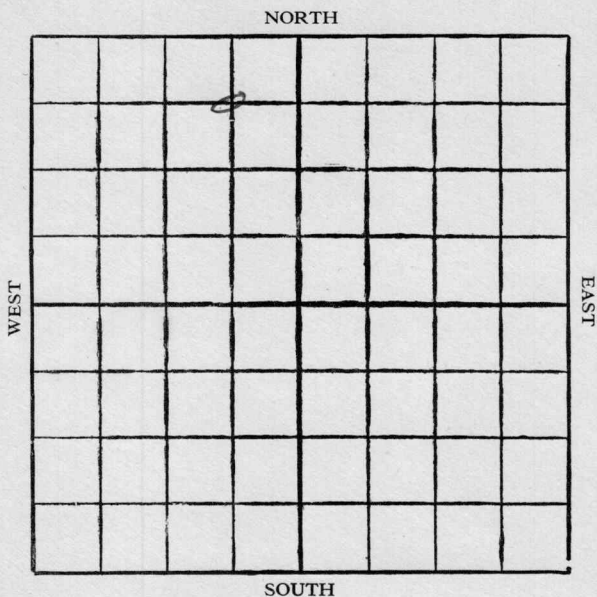

Location
Drilling Remarks

Rig Up.....
Drilling Remarks

RECORD

Cased..... in. ft.
Sand
Gas
Oil
Total Depth.....

PRODUCTION

1st 24 hrs. Nat.....
1st 24 hrs. after shot.....
Gas..... cu. ft.
Dry Hole.....
Abandoned.....

Elk

Map No. Kansas Sec. 31 Twp. 30 R 10^E

Well No. 1 Cummings Farm


L. J. J. Oil Company

660 Ft. from N. Line

_____ Ft. from S. Line

660 Ft. from E. Line

_____ Ft. from W. Line

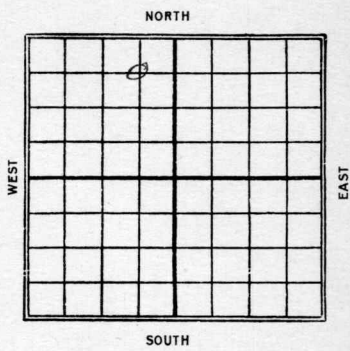

Date 1927 REPORT

1/8 Abandoned 1530'

6615
 9 KANSAS 31 Twp. 30 R. 10^E
 Map No. Sec. Twp. R.

Well No. 1 Cummings
 Indian Territory Oil Co
 Company

Contractor

FIRST REPORTS

SECTION PLAT

660 Ft. from N. Line

_____ Ft. from S. Line

660 Ft. from E. Line

_____ Ft. from W. Line

COMPLETED

	0		
ABANDONED			

Location _____

Rig up _____

Drilling and Remarks:

TL 1498

RECORD

Cased _____ in., _____ ft.

Sand _____

Gas _____

Oil _____

Total Depth 1530

PRODUCTION

1st 24 hrs. Nat. _____

1st 24 hrs. after shot. _____

Gas _____ Cu. Ft.

Dry Hole ✓

Abandoned ✓

Date

JAN 8 1927

CHAS. L. SHERWOOD

192

Scout