

Section 30 Township 18 Range 15W

Well No. #1 Haas

Company United Drlg. Inc.

NORTH

14


WEST

EAST

0

SOUTH

Barton

KANSAS

SEC. 30	TWP. 18	R. 15 W	✓
------------	------------	------------	---

WELL NO.

# 1 Haas

FARM

COMPANY

United Drlg. Inc.

CONTRACTOR

United Drlg.  
Otis-Albert Pool


\_\_\_\_\_ Ft. from N. Line

330 \_\_\_\_\_ Ft. from S. Line

\_\_\_\_\_ Ft. from E. Line

330 \_\_\_\_\_ Ft. from W. Line

SW SW SE

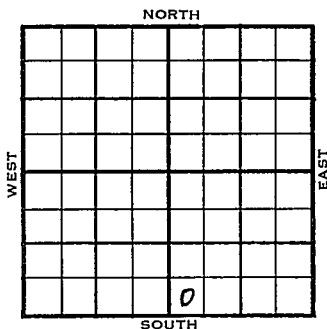

ELEVATION

1954

1917'

REPORT

4/7

Spud 4-3-54

Anhy 865'

8" @ 868

4/21

Spud 4-3-54 D & A TD 3498

Anhy 865 8" @ 868 Heeb 3128

Lans. 3196 B KC 3414 Reagan 3472

Granite 3492 TD 3498 D & A

**ABANDONED**




County Barton State Kansas

Sec. 30 (Blk. 18) (Sur. 15W) (Twp. 18) Map No.

Operator United Drlg., Inc.

Well No. 1 Farm Haas

Elev. 1917 Location SW SW SE

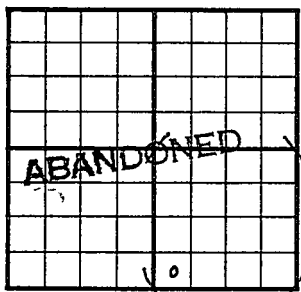

330 Ft. From S Line SE

330 Ft. From W Line Quarter

1st. Report

Completion APR 21 1954

Remarks Otis-Albert Pool

United Drlg. - Contr.

Spudding Date 4-3-54

Drlg. Data D & A TD 3498

Anhy 865 8" @ 868 Heeb. 3128

Lans. 3196 B KC 3414 Reagan 3472

Granite 3492 TD 3498

D & A