


Map No. KANSAS Sec. 32 Twp. 30 R. 10^E

Well No. 1-Record Farm
Empire & Ark. Fuel Company

330 Ft. from N. Line
~~330~~ Ft. from S. Line
940 Ft. from E. Line
 _____ Ft. from W. Line

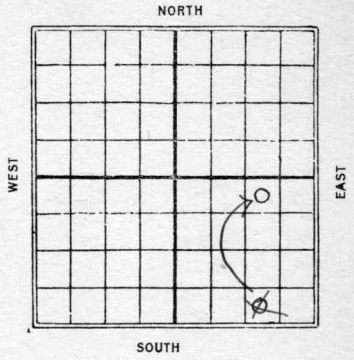

1929

Date	REPORT
10/30	Location
11/6	Rig up.
11/13	Spud 850.
11/20	Drily 250'
11/27	" 675'
12/4	SD. 760'
12/11	Top sand 1270' Oil 1287-97' est 5 bbls oil
12/23	SD. 1603'
12/30	—
1930	—
1/8	—
1/15	—
1/22	Top lime 2110' SD. 2115'
1/29	Drily 2310'
2/4	—
2/11	Base lime 2379 Top oil lined 2425' N7W 2432 - T.D. 2450 - P.B to 1297 - Will shoot (over)

2/19 - P.B Co 1310' - Shot 60
gts. - testing

2/26 —

3/6 - TD. 2450'

Dry & abandon

Map No. 9 **KANSAS** Sec. 32 Twp. 30 R. 10^E

Well No. 1 *Record.*

Empire & Ark Fuel Company

Contractor

FIRST REPORTS

..... Ft. from N. Line

330 Ft. from S. Line

990 Ft. from E. Line

..... Ft. from W. Line

SECTION PLAT

Location..... ✓

Rig up.....

Drilling and Remarks:

RECORD

Cased..... in., ft.

Sand.....

Gas.....

Oil.....

Total Depth.....

PRODUCTION

1st 24 hrs. Nat.....

1st 24 hrs. after shot.....

Gas..... Cu. Ft.

Dry Hole.....

Abandoned.....

Date

OCT 30 1929

..... 192..... Scout

CHAS. L. SHERWOOD

9 ^{Elk} KANSAS Sec. 32 Twp. 30 R. 10^E

Well No. 1 Record

Empire & ark Fuel Company

Contractor

CORRECTION

330 Ft. from N. Line

Ft. from S. Line

990 Ft. from E. Line

Ft. from W. Line

SECTION PLAT

			↑
			↓

Location

Rig up

Drilling and Remarks:

dry loc.

RECORD

Cased in., ft.

Sand

Gas

Oil

Total Depth

PRODUCTION

1st 24 hrs. Nat.

1st 24 hrs. after shot

Gas Cu. Ft.

Dry Hole

Abandoned

Date

DEC 1 1 1929

192 Scout

CHAS. L. SHERWOOD

Elk

Map No. 9 **KANSAS** Sec. 32 Twp. 30 R. 10

Well No. 1 *Record*

Empire & Ark Fuel Company

Contractor

COMPLETE

330 Ft. from N. Line

..... Ft. from S. Line

990 Ft. from E. Line

..... Ft. from W. Line

ABANDONED

SECTION PLAT

			0

Location.....

Rig up.....

Drilling and Remarks:

RECORD

Cased..... in., ft.

Sand.....

Gas.....

Oil.....

Total Depth 7450

PRODUCTION

1st 24 hrs. Nat.....

1st 24 hrs. after shot.....

Gas..... Cu. Ft.

Dry Hole

Abandoned

Date

MAR 5 1930

CHAS. L. SHERWOOD

192.....

Scout