


Barton

Section 12 Township 20 Range 12W

Well No. #3 Schartz "C"

Company C E Ash

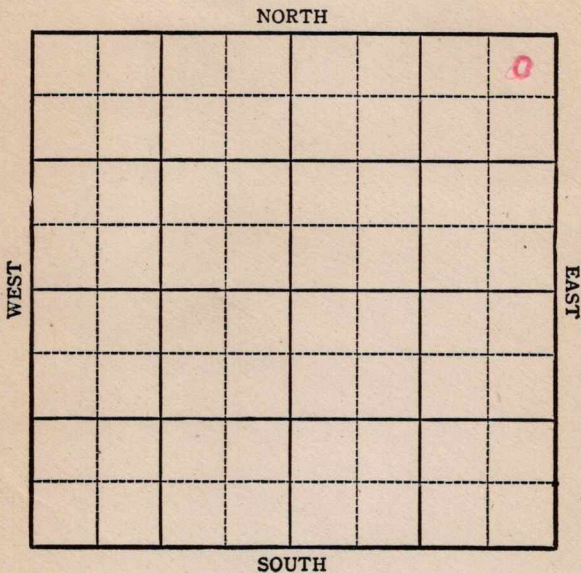

**KANSAS**

Barton

Sec. 12 Twp. 20 R. 12W

Well No. #3 Schartz "C" Farm

C E Ash Company


Marchand

330 Ft. from N. Line

         Ft. from S. Line

330 Ft. from E. Line

         Ft. from W. Line

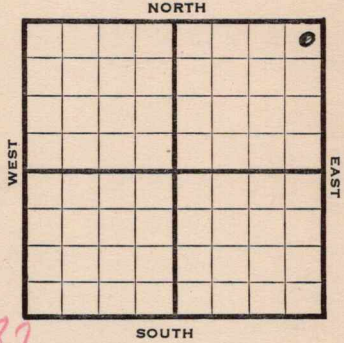

*NE/C Elev. 1787*

1944

REPORT

7/26 Rotary

- 8/9 Topeka 2725
- Lans 3084
- Arb. 3350
- TD 3383

**ABANDONED**

**KANSAS**

Pool Name Marchand

Map No. 46 Sec. 12 Twp. 20 R. 12W

Well No. 3 Schartz "C"

C. E. Ash Company

FIRST REPORT Contractor

NE/C

**SECTION PLAT**

330 Ft. from N. Line

\_\_\_\_\_ Ft. from S. Line

330 Ft. from E. Line

\_\_\_\_\_ Ft. from W. Line

				0

Barton County

Location \_\_\_\_\_

Rig up \_\_\_\_\_

Drilling and Remarks:

Rotary

**RECORD**

Cased \_\_\_\_\_ in., \_\_\_\_\_ ft.

Sand \_\_\_\_\_

Gas \_\_\_\_\_

Oil \_\_\_\_\_

Total Depth \_\_\_\_\_

**PRODUCTION**

1st 24 hrs. Nat. \_\_\_\_\_

1st 24 hrs. after shot \_\_\_\_\_

Gas \_\_\_\_\_ Cu. Ft.

Dry Hole \_\_\_\_\_

Abandoned \_\_\_\_\_

Date

JUL 26 1944 19

S. J. LEWIS Scout

KANSAS

Pool Name Marchand

Map No. 46 Sec. 12 Twp. 20 R. 12W

Well No. 3 Scharzt "C"

C. E. Ash Company

ABANDONED Contractor

NE/C

SECTION PLAT

330 Ft. from N. Line

\_\_\_\_\_ Ft. from S. Line

330 Ft. from E. Line

\_\_\_\_\_ Ft. from W. Line

			o

Barton County

Location \_\_\_\_\_

Rig up \_\_\_\_\_

Drilling and Remarks:

*Hope 62725*  
*Louis 3084*  
*Ar 7350*

RECORD

Cased \_\_\_\_\_ in., \_\_\_\_\_ ft.

Sand \_\_\_\_\_

Gas \_\_\_\_\_

Oil \_\_\_\_\_

Total Depth 3383

PRODUCTION

1st 24 hrs. Nat. \_\_\_\_\_

1st 24 hrs. after shot \_\_\_\_\_

Gas \_\_\_\_\_ Cu. Ft.

Dry Hole \_\_\_\_\_

Abandoned \_\_\_\_\_

Date

AUG 9 1944 19 \_\_\_\_\_

S. J. LEWIS Scout