


KANSAS

Section 25 Township 31 Range 6-E

Well No. #1 Manser

Company J H Waggnor

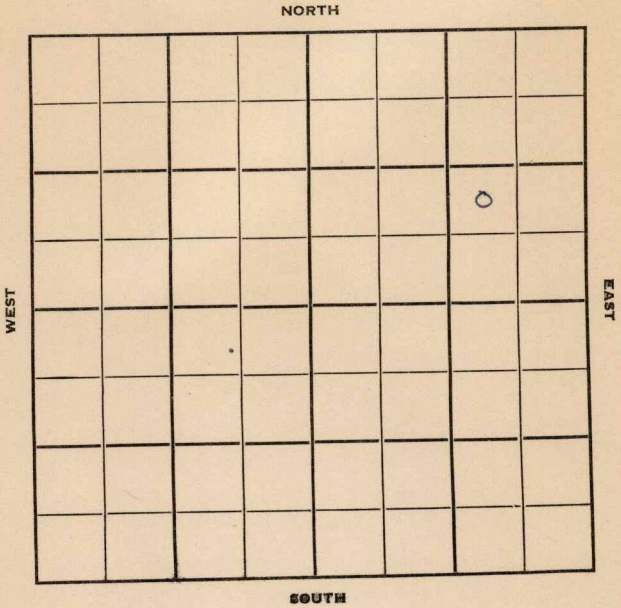

Sec. 25 Twp. 31 R. 6E ✓

Well No. #1 Manser Farm

J. H. Weggnor Company

Contractor

Manser Pool


_____ Ft. from N. Line

990' Ft. from S. Line

990' Ft. from E. Line

_____ Ft. from W. Line

NW SE NE

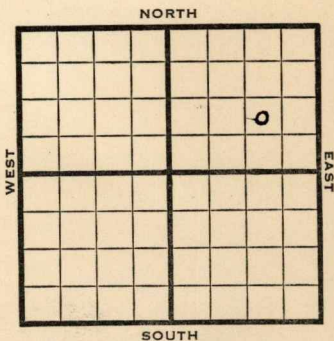

1950

Elev 1337

REPORT

8/9

Spud 8-3-50

12½" @ 345'

Drlg. 475'

9/6

12½" @ 345

10" @ 1195

7" @ 1843

Layton 2135 -45 KC 2540-72 TD

TD 2572

D&A

ABANDONED

