

KANSAS

FORM 51 5M 10-41 PETROL


Barton

Section 12 Township 20 Range 12-W

Well No. #1 Mike Schartz

Company Comet Drilling

Marchand Pool

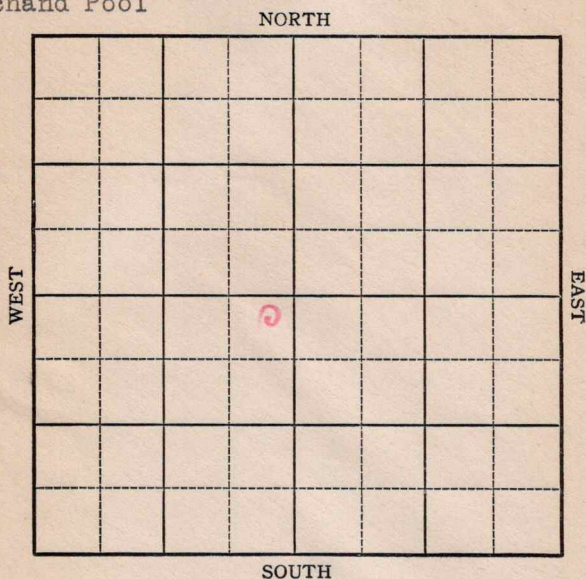

KANSAS

Barton

Sec. 12 Twp. 20 R. 12W

Well No. 1-Mike Schartz Farm


Comet Drilling Company
(Marchand pool)

330 Ft. from N. Line

Ft. from S. Line

330 Ft. from E. Line

Ft. from W. Line

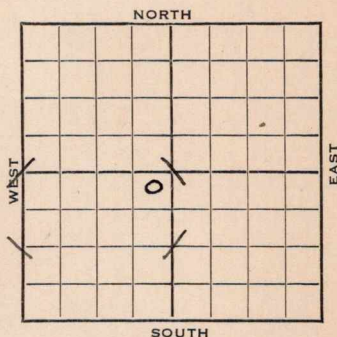

NE SW

Elev. 1792

1942

REPORT

9/23 Location

9/30 RUR

10/7 10" - 310 Anhy 540 Drlg. 1090

10/14 Lans. 3090
Drlg. 3120'

10/21 Arb 3344 Sat 3347 TD 3348 7"
@ 3346 Rust.

10/28 Drlg. 3387 Noshows

11/4 Arb. 3344'
7" @ 3346'
no shows, TD 3412'

ABANDONED

Barton

Map No. 46 Sec. 12 Twp. 20 R. 12W

Well No. 1 Mike Schartz

Comet Drilling

Company

FIRST REPORT

Contractor

NE SW


330 Ft. from N. Line

Ft. from S. Line

330 Ft. from E. Line

Ft. from W. Line

SECTION PLAT

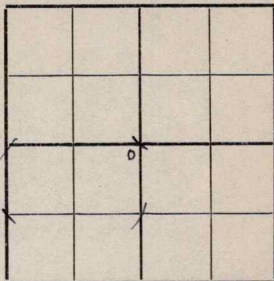

MARCHAND POOL

Location XXX

Rig up

Drilling and Remarks:

RECORD

Cased _____ in., _____ ft.

Sand _____

Gas _____

Oil _____

Total Depth _____

PRODUCTION

1st 24 hrs. Nat. _____

1st 24 hrs. after shot _____

Gas _____ Cu. Ft.

Dry Hole _____

Abandoned _____

Date

SEP 23 1942 19

S. J. LEWIS Scout


Barton

KANSAS

Map No. 46 Sec. 12 Twp. 20 R. 12WWell No. 1 Mike SchartzComet Drilling CompanyABANDONED Contractor

NE SW

SECTION PLAT

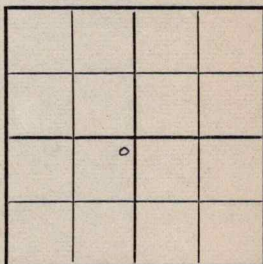330 Ft. from N. Line Ft. from S. Line330 Ft. from E. Line Ft. from W. Line

MARCHAND POOL

Location Rig up

Drilling and Remarks:

Per 833447" 83346No shows.

RECORD

Cased in., ft.Sand Gas Oil Total Depth 8412

PRODUCTION

1st 24 hrs. Nat. 1st 24 hrs. after shot Gas Cu. Ft.Dry Hole Abandoned

Date

NOV 4 1942 19S. J. LEWIS Scout