


Map No. KANSAS Sec. 29 Twp. 18 R. 15-W

Well No. 1-Hunter Farm _____
Schermerhorn Company _____

NORTH

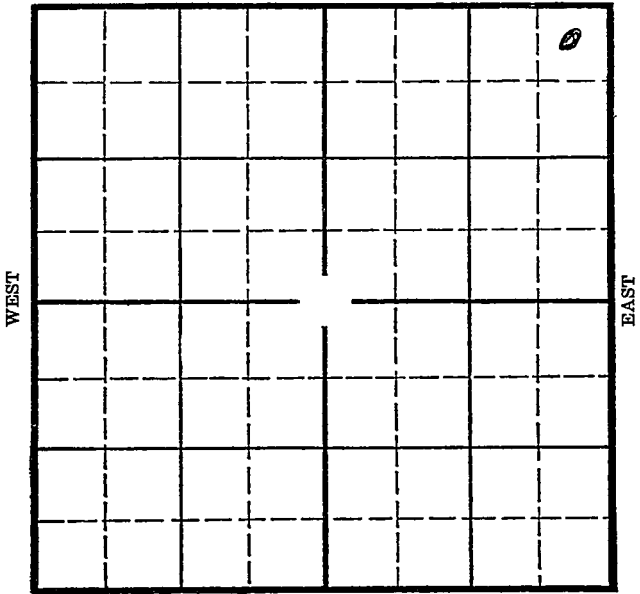

SOUTH

Location _____
Drilling Remarks _____

Rig Up _____
Drilling Remarks _____

RECORD

PRODUCTION

Cased _____ in. _____ ft.
Sand _____
Gas _____
Oil _____
Total Depth _____

1st 24 hrs. Nat. _____
1st 24 hrs. after shot _____
Gas _____ cu. ft. _____
Dry Hole _____
Abandoned _____

Barton
18 R. 15^W

KANSAS

Map No. _____ Sec. 29 Twp. _____ R. _____

Well No. 1 Hunter Farm _____


Schumerhorn Company _____

330 Ft. from N. Line

_____ Ft. from S. Line

330 Ft. from E. Line

_____ Ft. from W. Line

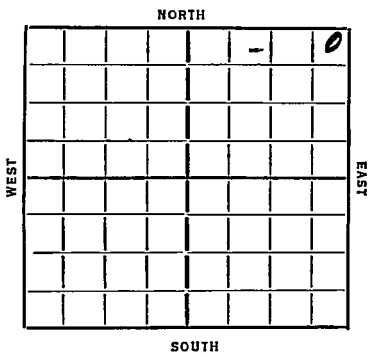

Elev. 1911

REPORT

1936	
3/8	Location
3/20	--
3/27	Spud.
4/2	S.D. @ 380'
4/10	Drlg. 785'
4/16	Drlg. 1650'
4/23	10" @ 2366' C.O.
4/30	Drlg. 2710'
5/7	Run 8" @ \pm 3180'.
5/14	Oswald 3194'. Set 8". 2 BW 3220-35' 7" @ 3408' Drlg.
5/21	3487'. U.R. 6".
5/28	6" @ 3482'. 2 M. Gas at 3487'. T.D. 3516'. Estimated 38 $\frac{1}{2}$ M. Gas.
6/4	Quartzite 3565'. T.D. 3576'. P.B. 3540'. Show of oil.
6/11	--
6/18	Shut down.
6/25	--
7/2	P.B. 3534'. 39 million gas. Fishing
7/9	--
7/16	P.B. 3530-9 million cuft. of gas.

OVER

Map No. 73 Sec. 29 Twp. 18 R. 15 W

Well No. 1 - Hunter

Schermerhorn Company

Contractor

FIRST REPORT

SECTION PLAT

330 Ft. from N. Line

..... Ft. from S. Line

330 Ft. from E. Line

..... Ft. from W. Line

			0

Location.....

Rig up.....

Drilling and Remarks:

RECORD.

Cased..... in., ft.

Sand.....

Gas.....

Oil.....

Total Depth.....

PRODUCTION

1st 24 hrs. Nat.....

1st 24 hrs. after shot.....

Gas..... Cu. Ft.

Dry Hole.....

Abandoned.....

Date

MAR 19 1936

ORVAL MANNSCHRECK

192.....

Scout

Map No. 73 Sec. 29 Twp. 18 R. 15W

Well No. 1 Hunted

Schmerhorn Company

Contractor

SECTION PLAT

			2

320 Ft. from N. Line

_____ Ft. from S. Line

320 Ft. from E. Line

_____ Ft. from W. Line

COMPLETED

Location _____

Rig up _____

Drilling and Remarks:

Gas Sand 3487

P.B 3515

39 M Gas.

RECORD

Cased _____ in., _____ ft.

Sand _____

Gas _____

Oil _____

Total Depth 3528

PRODUCTION

1st 24 hrs. Nat. _____

1st 24 hrs. after shot _____

Gas _____ Cu. Ft.

Dry Hole _____

Abandoned _____

Date

JUL 29 1936

S. J. LEWIS Scout

7/23-18 million cubic feet of gas.

7/29/36-Gas sand 3487'. TD 3576'.
Plug back to 3518'.

39 million cubic feet of gas.

COMPLETED