


Map No. KANSAS Sec. 30 Twp. 30 R. 10^E
Well No. 2-2 Prodigress Farm
A. M. Landon Company

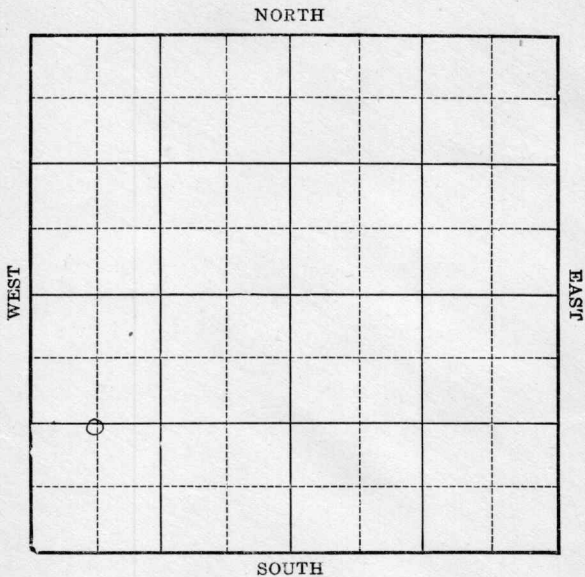

Location _____
Drilling Remarks _____

RECORD

Cased _____ in. _____ ft.
Sand _____
Gas _____
Oil _____
Total Depth _____


Rig Up _____
Drilling Remarks _____

PRODUCTION

1st 24 hrs. Nat. _____
1st 24 hrs. after shot _____
Gas _____ cu. ft.
Dry Hole _____
Abandoned _____

Map No. KANSAS Sec. 30 Twp. 30 R. 10^E
 Well No. 2-Modgrass Farm
A.M. Landon Company

NORTH

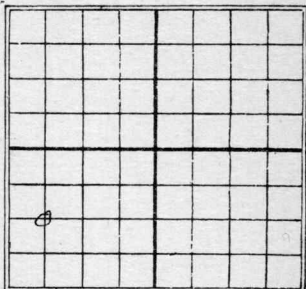

_____ Ft. from N. Line

1320 Ft. from S. Line

_____ Ft. from E. Line

660 Ft. from W. Line

1930

SOUTH

Date

REPORT

12/3 Spdy.
 12/10 8"-900.
 Dry 950
 12/17 Top Gas sand 1450
 dry
 T.D. 1471
 Dry & Abandon

Map No. KANSAS Sec. 30 Twp. 30 R. 10^E
 Well No. 2 Shodgrass
H. M. Landon Company

Contractor

FIRST REPORTS

SECTION PLAT

Ft. from N. Line

1320 Ft. from S. Line

Ft. from E. Line

660 Ft. from W. Line

Location

Rig up

Drilling and Remarks:

Spily

RECORD

Cased _____ in., _____ ft.

Sand _____

Gas _____

Oil _____

Total Depth _____

PRODUCTION

1st 24 hrs. Nat. _____

1st 24 hrs. after shot _____

Gas _____ Cu. Ft.

Dry Hole _____

Abandoned _____

Date

DEC 3 1930

CHAS. L. SHERWOOD

192

Scout

Eli

Map No. KANSAS Sec. 30 Twp. 30 R. 10 ^EWell No. 2 MudgrassA. M. Landon Company

Contractor

COMPLETE

SECTION PLAT

Ft. from N. Line

1320 Ft. from S. Line

Ft. from E. Line

660 Ft. from W. Line

ABANDONED

Location

Rig up

Drilling and Remarks:

Tap gas sand
at 1450' dry.

RECORD

Cased _____ in., _____ ft.

Sand _____

Gas _____

Oil _____

Total Depth 1471

PRODUCTION

1st 24 hrs. Nat. _____

1st 24 hrs. after shot _____

Gas _____ Cu. Ft.

Dry Hole ☒Abandoned ☒

Date

DEC 17 1930

192

CHAS. L. SHERWOOD

Scout