


FORM 51 5M PETROL

Section 31 Township 18 Range 15W

Well No. 2 Dirks

Company Aylward Prod

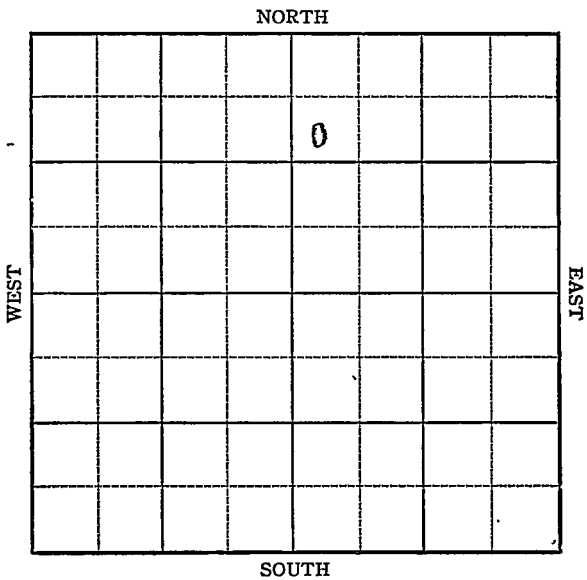

Sec. 31 Twp. 18 R. 15W

Well No. 2 Dirks Farm

Aylward Prod Company

Albert


990 Ft. from N. Line

_____ Ft. from S. Line

_____ Ft. from E. Line

330 Ft. from W. Line

SW NW NE Elev. 1942

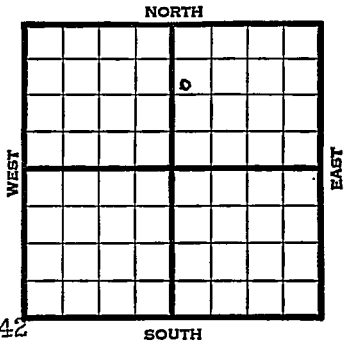

1945

REPORT

5/9	Location	
5/17	Anhy	945
	8" @ 956	
	Drlg. 2345'	
5/24	Cong	3536
	Drlg. 3523	
5/31	Reagan	3530
	5" @ 3531	
	TD 3568	
	1450' oil 8 hrs.	
6/8	Swb. 2 1/2 oil P.H. 8 hrs.	
6/14	" " " "	
6/21	" " " "	
7/3	Reagan 3530	
	5" @ 3531	
	Pump 50 Pot.	
	TD 3568'	
	Grav. 36.0	

COMPLETED

Kansas Pool Name Albert

Map No. K-73 Sec. 31 Twp. 18 R. 15W

Well No. 2 Dirks

Aylward Prod Company

FIRST REPORT

Contractor

SW NW NE

SECTION PLAT

990 Ft. from N. Line

_____ Ft. from S. Line

_____ Ft. from E. Line

330 Ft. from W. Line

		o	

Barton County

Location X

Rig up _____

Drilling and Remarks:

RECORD

Cased _____ in., _____ ft.

Sand _____

Gas _____ A₁

Oil _____

Total Depth _____

PRODUCTION

1st 24 hrs. Nat. _____

1st 24 hrs. after shot _____

Gas _____ Cu. Ft.

Dry Hole _____

Abandoned _____

Date

MAY 9 1945

S. J. LEWIS Scout

KANSAS Pool Name AlbertMap No. 93 Sec. 31 Twp. 18 R. 15WWell No. 2 DirksAylward Prod.

Company

COMPLETED

Contractor

SW NW NE

E. 1942
SECTION PLAT990 Ft. from N. Line Ft. from S. Line Ft. from E. Line330 Ft. from W. Line

		0	

Barton County

Location Rig up

Drilling and Remarks:

Reagan 2530
500331
Pump 50 P 8

36² Gr

RECORD

Cased in., ft.Sand Gas Oil Total Depth 3538

PRODUCTION

1st 24 hrs. Nat. 1st 24 hrs. after shot Gas Cu. Ft.Dry Hole Abandoned

Date

JUL 3 1945. 19

S. J. LEWIS Scout