

Section 25 Township 31 Range 6 E

Well No. # 3 Snyder

Company Murfin Drlg.

NORTH

		0					

WEST

EAST

SOUTH

Sec. 25 Twp. 31 R. 6 E

Well No. # 3 Snyder Farm

Murfin Drlg. Company

Coppitt Contractor


330 Ft. from N. Line

_____ Ft. from S. Line

990 Ft. from E. Line

_____ Ft. from W. Line

NW NE SW

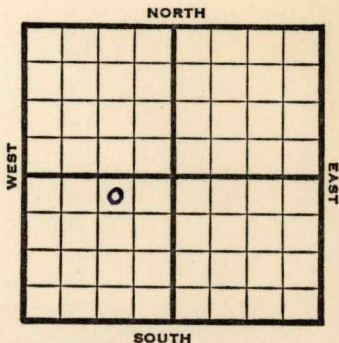

1952

Elev. 1411'

REPORT

8/13

MIR

10/8

Spud 8-11-52

D & A TD 2208' **Layton 2198'**

TD 2186' 5" @ 2177 DD 2109' SO

DD 2208' 20 qt/ S/32' **oil**

900' water.

D & A

ABANDONED

