

Cowley

Well No. 1 Hall Farm

_____ Dan Patton _____ Company

NORTH

WEST

EAST

SOUTH

Rig Up-----
Drilling Remarks

PRODUCTION

1st 24 hrs. Nat.

1st 24 hrs. after shot

Gas _____ cu. ft.

Dry Hole

Abandoned

Cowley

Map No. **KANSAS** Sec. 29 Twp 31 R. 6E

Well No. 1 Hall Farm


Dan Patton Company

250 Ft. from N. Line

_____ Ft. from S. Line

_____ Ft. from E. Line

250 Ft. from W. Line

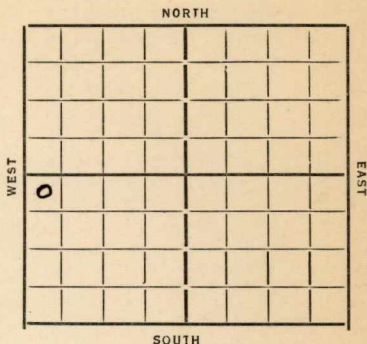

Date
1934

REPORT

5/2 Rig up
5/10 — 5/18 — 5/25 —
5/31 dclg 455
6/7 " 1380 15" 480 12" 1187
6/14 dclg 1970 10" 1455
6/21 sd 1970
6/28 —
7/5 5" 2904 TD 3055
7. Bait 3053 flo ³²⁰ ~~320~~ Bbls 15 hrs
7/11 Sand 2953 TD 2955
320 Bbls.

COMPLETED

KANSAS

Map No. 20 Sec. 29 Twp. 31 R. 6E

Well No. 1-Hall

Dan Patton Company

Contractor

FIRST REPORTS

SECTION PLAT

0			

250 Ft. from N. Line

_____ Ft. from S. Line

_____ Ft. from E. Line

250 Ft. from W. Line

Location _____

Rig up _____

Drilling and Remarks:

RECORD

Cased _____ in., _____ ft.

Sand _____

Gas _____

Oil _____

Total Depth _____

PRODUCTION

1st 24 hrs. Nat. _____

1st 24 hrs. after shot _____

Gas _____ Cu. Ft.

Dry Hole _____

Abandoned _____

Date

5-2-34

19

ORVAL MANNSCHRECK

Scout

Map No. 2 Sec. 29 Twp. 31 R. 6E

Well No. 1-Hall

Don Patton Company

Contractor

COMPLETED

SECTION PLAT

0			

250 Ft. from N. Line

_____ Ft. from S. Line

_____ Ft. from E. Line

250 Ft. from W. Line

Location _____

Rig up _____

Drilling and Remarks:

320 fth

RECORD

Cased _____ in. _____ ft.

Sand 2953

Gas _____

Oil _____

Total Depth 2955

PRODUCTION

1st 24 hrs. Nat. _____

1st 24 hrs. after shot _____

Gas _____ Cu. Ft.

Dry Hole _____

Abandoned _____

Date

7-11-34 19

ORVAL MANNSCHRECK
Scout