


Section 31 Township 18 Range 15-W

Well No. 2 Wissman

Company Aylward

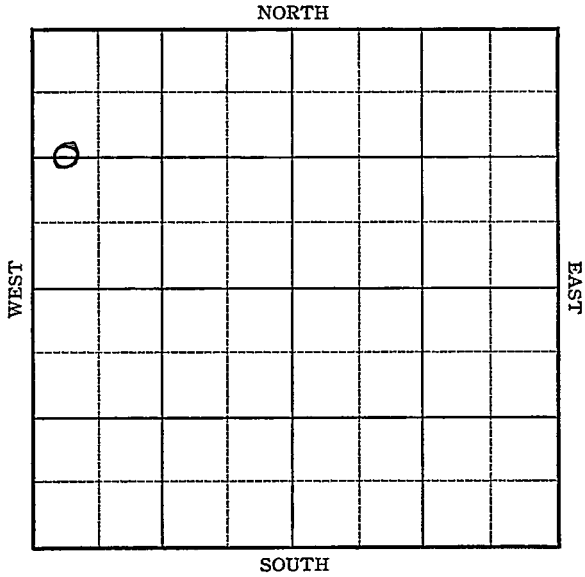


Sec. 31 Twp. 18 R. 15-WWell No. #2 Wissman FarmAylward Company1320 Ft. from N. Line

_____ Ft. from S. Line

330 Ft. from E. Line

_____ Ft. from W. Line

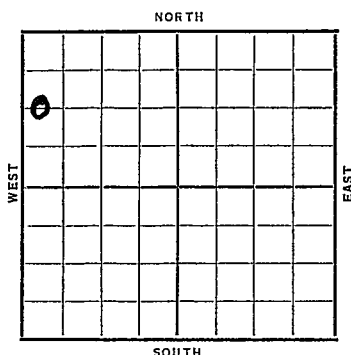

Elev. 1962

Date	REPORT
1938	
1/5	Mat'l.
1/14	"
1/20	"
1/28	R.R.
2/4	R.U.R.
2/11	T.D. 832'. WOC.
2/18	" " "
2/26	10" @ 850'. Drlg. 3000'.
3/4	6" @ 3542'. Cleaning out.
3/11	Cong. 3542'. Regan sand 3545'.
	Est. 1 M gas & flowed 5 bbls.
	oil per hour @ 3564'.
	T.D. 3578'. Flow 25 oil per hr.
	Shot 40 qts.
3/18	Swab 145 oil in 4 hrs.
	OVER

Map No. 73 Sec. 31 Twp. 18 R. 15W

Well No. 2 Wissman

Aylward

Company

Contractor

FIRST REPORT

SECTION PLAT

1320 **C W L NW**
Ft. from N. Line

_____ Ft. from S. Line

330 Ft. from E. Line

_____ Ft. from W. Line

0			

Location _____

Rig up _____

Drilling and Remarks:
Matl.

RECORD

Cased _____ in., _____ ft.

Sand _____

Gas _____

Oil _____

Total Depth _____

PRODUCTION

1st 24 hrs. Nat. _____

1st 24 hrs. after shot _____

Gas _____ Cu. Ft.

Dry Hole _____

Abandoned _____

Date

JAN 5 - 1938 19

H. D. Hatfield Scout

Barton KANSAS

Map No. 73 Sec. 31 Twp. 18 R. 15WWell No. 2 WissmanAylward

Company

Contractor

COMPLETED

SECTION PLAT

C W L NW
1320 Ft. from N. Line

_____ Ft. from S. Line

_____ Ft. from E. Line

330 Ft. from W. Line

0			

Location _____

Rig up _____

Drilling and Remarks:

*shot 40 gals
Pot 958
Flow*

RECORD

Cased 6 in., 3542 ft.Sand Arb 3572Gas Regan 3576

Oil _____

Total Depth 3578

PRODUCTION

1st 24 hrs. Nat. _____

1st 24 hrs. after shot _____

Gas _____ Cu. Ft.

Dry Hole _____

Abandoned _____

Date

MAR 23 1938 19

H. D. Hatfield

Scout

1938

3/23

6" @ 3542'.

Arb. 3572'.

Regan 3576'.

T.D. 3578'.

Shot 40 qts.

Potential 958 bbls., flow.

COMPLETED