


Map No. **KANSAS** Sec. 29 Twp. 31 R. 6^E

Well No. 1- Patton Farm Patton Company

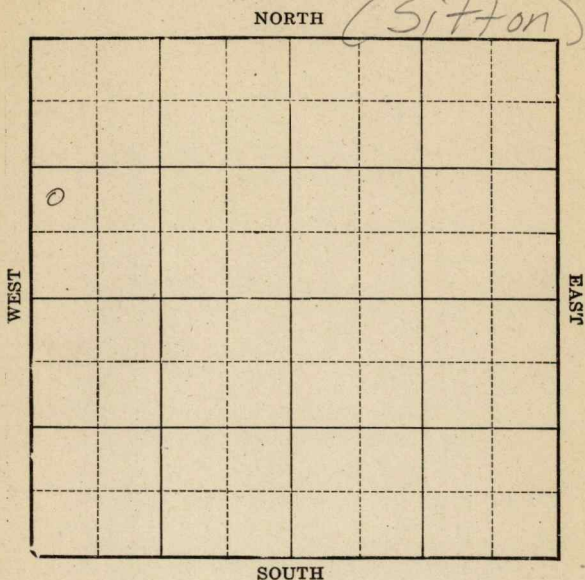

Location _____
Drilling Remarks _____

Rig Up _____
Drilling Remarks _____

RECORD

Cased _____ in. _____ ft.
Sand _____
Gas _____
Oil _____
Total Depth _____

PRODUCTION

1st 24 hrs. Nat. _____
1st 24 hrs. after shot _____
Gas _____ cu. ft.
Dry Hole _____
Abandoned _____

Cowley
Map No. **KANSAS** Sec. 29 Twp. 31 R. 6^E
Well No. 1- Littleton Farm
Dan Patton Chal Company


_____ Ft. from N. Line

1070 Ft. from S. Line

_____ Ft. from E. Line

250 Ft. from W. Line

1931

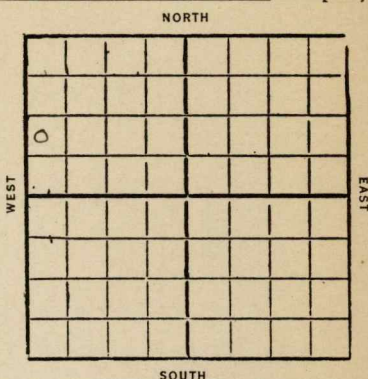

Date

REPORT

12/9 Rob
12/16 Drill rig
12/22 Drill
12/30
1932
1/6 Drill 915'
1/13 SD 1475'
1/20 10"-1465
Drill 1645'
1/27 12"-1040
10"-1465
8"-1635
6"-2020
Drill 2030'
2/3 " 2775'
2/10 Cased 5"-2887
Sand 2884-2963
T.D. 2963
shot 80 qt
150 bbl oil
Comp.

Cowley

Map No. **KANSAS** Sec. 29 Twp. 31 R. 6^EWell No. 1 SitteonDan Patton & al Company

Contractor

FIRST REPORTS

SECTION PLAT

0			

Ft. from N. Line

1070 Ft. from S. Line

Ft. from E. Line

250 Ft. from W. Line

Location

Rig up

Drilling and Remarks:

Rog

RECORD

Cased.....in.,ft.

Sand.....

Gas.....

Oil.....

Total Depth.....

PRODUCTION

1st 24 hrs. Nat.....

1st 24 hrs. after shot.....

Gas.....Cu. Ft.

Dry Hole.....

Abandoned.....

Date

DEC 9 1931

CHAS. L. SHERWOOD

192.....

Scout

Cowley

2 **KANSAS** Map No. Sec. 29 Twp. 31 R. 6 ^EWell No. 1 Sittew
Dan Patton & Co Company

Contractor

COMPLETED**SECTION PLAT**

0			

_____ Ft. from N. Line

1070 Ft. from S. Line

_____ Ft. from E. Line

250 Ft. from W. Line

Location _____

Rig up _____

Drilling and Remarks:

80/150 Bhs.

RECORD

Cased 5" in., 2887 ft.

Sand 2884 - 2963

Gas _____

Oil _____

Total Depth 2963

PRODUCTION

1st 24 hrs. Nat. _____

1st 24 hrs. after shot _____

Gas _____ Cu. Ft.

Dry Hole _____

Abandoned _____

Date

FEB 10 1932

19

CHAS. L. SHERWOOD

Scout