


Map No. Kansas Sec. 28 Twp. 37 R. 7 Butler

Well No. 6 Tobe Farm _____
Manhattan Oil Company

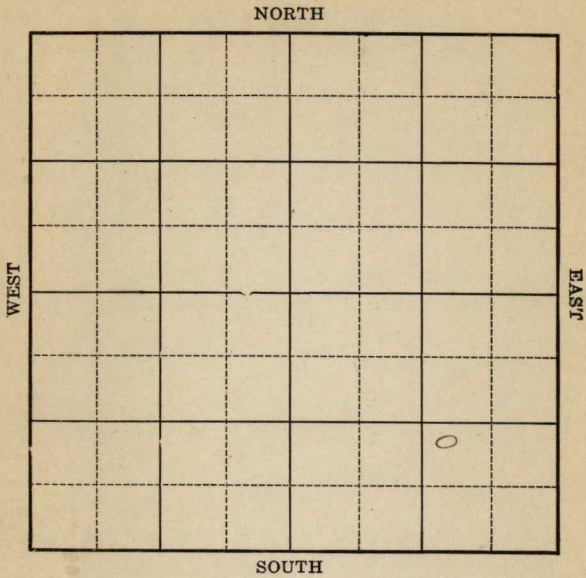

Location _____

Drilling Remarks _____

Rig Up _____

Drilling Remarks _____

RECORD

Cased _____ in. _____ ft.

Sand _____

Gas _____

Oil _____

Total Depth _____

PRODUCTION

1st 24 hrs. Nat. _____

1st 24 hrs. after shot _____

Gas _____ cu. ft.

Dry Hole _____

Abandoned _____

Butler

Map No. Kansas Sec. 28 Twp. 27 R. 7

Well No. 6 Jobe Farm


Manhattan Oil Company

..... Ft. from N. Line

785 Ft. from S. Line

1070 Ft. from E. Line

..... Ft. from W. Line

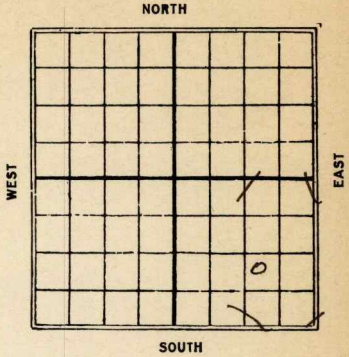

Date	REPORT
7/26	
5/26	Location
6/2	—
6/10	same
6/18	—
6/25	—
6-30	Fur holes
7/8	Rig
7/15	—
7/22	spudding
7/28	S.D. 415
8/4	Dlg 1200
8/11	" 1590
8/18	" 2190
8/25	" 2360
8-31	zap vlog ⁸ oil 2735-4i in sd tho 30 ft. 100' 0 1/2".
9/15	sand 2698-2741
	1st show oil 2735-
	30/Dry & aband.

K10 KANSAS Section 28 Twp. 27 R. 7

Well No. 6 Jobe
Manhattan oil Co. Company

Contractor

FIRST REPORTS

SECTION PLAT

785 Ft. from N. Line
1070 Ft. from S. Line
Ft. from E. Line
Ft. from W. Line

4x4 grid section plat with a small circle in the bottom right cell.

Location ✓
Rig up
Drilling and Remarks:

RECORD

Cased in., ft.
Sand
Gas
Oil
Total Depth

PRODUCTION

1st 24 hrs. Nat.
1st 24 hrs. after shot
Gas Cu. Ft.
Dry Hole
Abandoned

Date

MAY 26 1926

CHAS. L. SHERWOOD

192 Scout

Butler

10 **KANSAS** Sec. 28 Twp. 27 R. 7

Well No. 6 *Gobel*
Manhattan *al Co* Company

Contractor

COMPLETED

SECTION PLAT

_____ Ft. from N. Line

785 Ft. from S. Line

1070 Ft. from E. Line

_____ Ft. from W. Line

ABANDONED

			X
			o
			X

Location _____

Rig up _____

Drilling and Remarks:

1st show at 2735'

30 day 2 hrs
20 2741'

RECORD

Cased _____ in., _____ ft.

Sand *2698-2741'*

Gas _____

Oil _____

Total Depth *2741'*

PRODUCTION

1st 24 hrs. Nat. _____

1st 24 hrs. after shot _____

Gas _____ Cu. Ft.

Dry Hole

Abandoned

Date

SEP 15 1926

CHAS. L. SHERWOOD

192

Scout