

Map No. 5 Sec. 33 Twp. 30 R. 10

Well No. 1 Thompson Farm


J E Huff Company

660 Ft. from N. Line

_____ Ft. from S. Line

660 Ft. from E. Line

_____ Ft. from W. Line

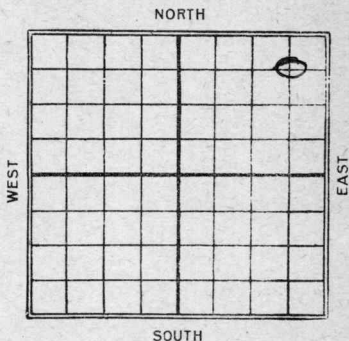

Date 1924

REPORT

<u>4/23</u>	<u>Log 1500</u>
<u>5/10</u>	<u>blowing depth 2140?</u>
<u>7/16</u>	<u>Tap L. 2115 10+9</u> <u>2140'</u>

Map No. **KANSAS** 9 Sec. 33 Twp. 30 R. 10

Well No. 1 *Sharpe*

J. E. Huff Company

Contractor

FIRST REPORT

SECTION PLAT

660' **SPECIAL**
Ft. from N. Line

_____ Ft. from S. Line

660' Ft. from E. Line

_____ Ft. from W. Line

			0

Location _____

Rig up _____

Drilling and Remarks:

6" - 1338
Only 1500'

RECORD

Cased _____ in., _____ ft.

Sand _____

Gas _____

Oil _____

Total Depth _____

PRODUCTION

1st 24 hrs. Nat. _____

1st 24 hrs. after shot _____

Gas _____ Cu. Ft.

Dry Hole _____

Abandoned _____

Date **APR 23 1924**

M. A. BENEAR

_____ 192_____

_____ Scout

Map No. 9 Kans Sec. 33 Twp. 30 R. 10

Well No. 1 - Thorpe

J. E. Huff Company

Contractor

ABANDONED

SECTION PLAT

660 Ft. from N. Line

_____ Ft. from S. Line

660 Ft. from E. Line

_____ Ft. from W. Line

			○

Location _____

Rig up _____

Drilling and Remarks:

Tap. 2,2115
L.O.A.
2140'

RECORD

Cased _____ in., _____ ft.

Sand _____

Gas _____

Oil _____

Total Depth _____

PRODUCTION

1st 24 hrs. Nat. _____

1st 24 hrs. after shot _____

Gas _____ Cu. Ft.

Dry Hole _____

Abandoned _____

Date _____

M.A.B.

7/23/24
Scout