


KANSAS

Section 31 Township 18 Range 15-W

Well No. # 2 Bowyer "B"

Company Bay Pet.  
Mertens Pool

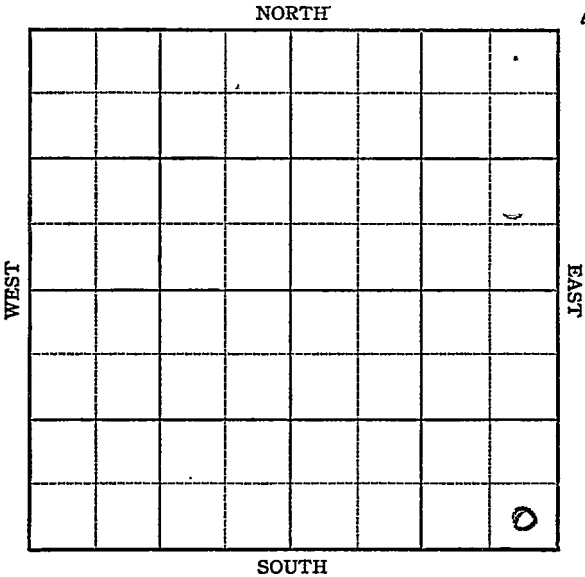


KANSAS

Sec. 31 Twp. 18 R. 15-W

Well No. #2 Boyer "B" Farm  
Bay Pet.

~~Wildcat~~ Company

         Ft. from N. Line  
330 Ft. from S. Line  
330 Ft. from E. Line  
         Ft. from W. Line  
SE/C

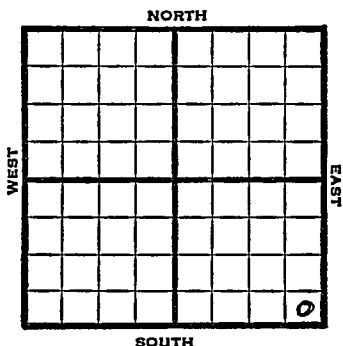

1947 Elev 1995' REPORT

6/11 8" @ 1000'  
Drlg 3315'

6/24 " "

7/1 TD 3630'  
Swb 10 bbls oil PH

7/8 " "

7/16 Basa 3622'  
5" @ 3623'  
Pump 50 Pot  
Gr. 36  
T.D. 3630'  
Complete

COMPLETED



Map No. 73 Sec. 31 Twp. 18 R. 15W

Well No. 2 Bowyer "B"

Bay Pet. Company

**CORRECTION** Contractor

SE/C

SECTION PLAT

         Ft. from N. Line

330 Ft. from S. Line

330 Ft. from E. Line

         Ft. from W. Line


Barton County

Location \_\_\_\_\_

Rig up \_\_\_\_\_

Drilling and Remarks:

Reported  
31-18-14W

RECORD

Cased \_\_\_\_\_ in., \_\_\_\_\_ ft.

Sand \_\_\_\_\_

Gas \_\_\_\_\_

Oil \_\_\_\_\_

Total Depth \_\_\_\_\_

PRODUCTION

1st 24 hrs. Nat. \_\_\_\_\_

1st 24 hrs. after shot \_\_\_\_\_

Gas \_\_\_\_\_ Cu. Ft.

Dry Hole \_\_\_\_\_

Abandoned \_\_\_\_\_

Date

JUN 1 1 1947

19

S. J. LEWIS

Scout

Map No. 73 Sec. 31 Twp. 18 R. 15W

Well No. 2 Bowyer "B"

Bay Pet. Company

**COMPLETE**

Contractor

SE/C

*E 11995*  
SECTION PLAT

			o

\_\_\_\_\_ Ft. from N. Line

330 Ft. from S. Line

330 Ft. from E. Line

\_\_\_\_\_ Ft. from W. Line

Barton County

Location \_\_\_\_\_

Rig up \_\_\_\_\_

Drilling and Remarks:

*Base 6 3622*

*5" @ 3623*

*Pump 50 Pst*

*36 2/3*

**RECORD**

Cased \_\_\_\_\_ in., \_\_\_\_\_ ft.

Sand \_\_\_\_\_

Gas \_\_\_\_\_

Oil \_\_\_\_\_

Total Depth 3680

**PRODUCTION**

1st 24 hrs. Nat. \_\_\_\_\_

1st 24 hrs. after shot \_\_\_\_\_

Gas \_\_\_\_\_ Cu. Ft.

Dry Hole \_\_\_\_\_

Abandoned \_\_\_\_\_

Date

JUL 16 1947 19

S. J. LEWIS Scout