

Cowley

KANSAS

26

31


~~##~~ 6E

SECTION _____ TOWNSHIP _____ RANGE _____

WELL NO. #1 Underwood

COMPANY Thomas D. Young

NORTH

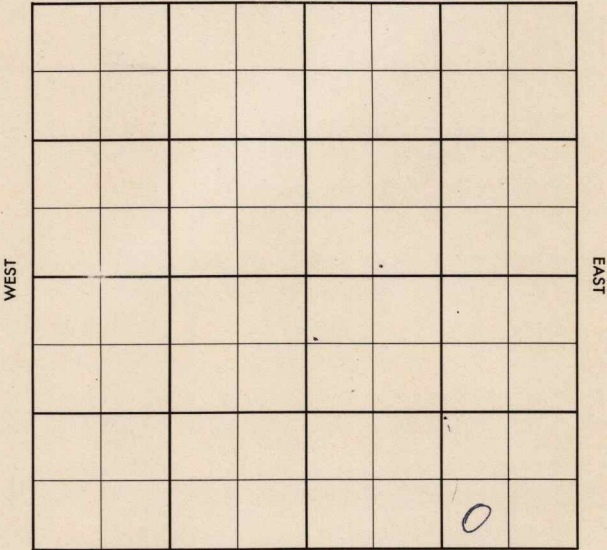

SOUTH

Co.

County Cowley Elev. _____
 Sec. 26 Twp. 31 Rge. 6E
 Company Thomas D. Young
 Farm Name Underwood No. 1

TOPS	DEPTH	LOG	DATUM	Loc. in Sec.
Anh.				SW SE SE
Tp.				
H.				
Tr.				
Dg.				
Bl.				
L.				Geol.
K.C.				Contr.
B.K.C.				See-Ro-Bee
Ce.				
C.				Pool
M.				Mansur
M.				
K.				
Mz.				
Me.				
V.				
S.				
S.				
A.				
R.				
Pe.				
G.				
T.D.				

Lse.

No.

Sec.

T.

R.

Date Comm.

Tex DHM

Location

DEC 19 '56

DEC 26 '56

JAN 2 '57

JAN 9 '57

JAN 16 '57

JAN 23 '57

JAN 30 '57

FEB 6 '57

FEB 13 '57

FEB 20 '57


Abd Loc.

County Cowley Elev. _____
 Sec. 26 Twp. 31 Rge. 6E
 Company Thomas D. Young
 Farm Name Underwood No. 1

TOPS	DEPTH	LOG	DATUM	Loc. in Sec.
Anh.				SW SE SE
Tp.				
H.				
Tr.				
Dg.				
Bl.				
L.				Geol. _____
K.C.				Contr. _____
B.K.C.				See-Ro-Bee
Ce.				
C.				Pool
M.				Mansur
M.				
K.				
Mz.				
Mq.				
V.				
S.				
S.				
A.				
R.				
PE.				
G.				
T.D.				

Date Comm.

Location

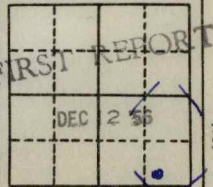

Co.

Lse.

No.

Sec.

T.

R.