




*ELK*

Map No. *Kansas* Sec. *4* Twp. *30* R. *11<sup>E</sup>*

Well No. *1* *Bonnett* Farm  
*Meridon oil* Company

*200* Ft. from N. Line  
\_\_\_\_\_ Ft. from S. Line  
*200* Ft. from E. Line  
\_\_\_\_\_ Ft. from W. Line

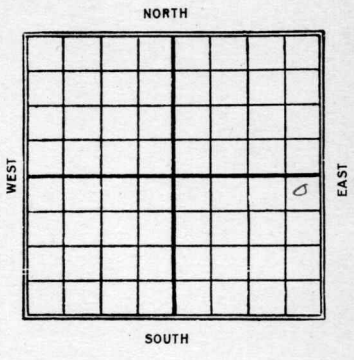

Date  
*1927*  
*1/8*

REPORT

*Abandoned 2278*

9 KANSAS Map No. Sec. 4 Twp. 30 R. 11

Well No. 1 Bonnett  
The Riggs Oil Co. Company

Contractor

FIRST REPORTS

SECTION PLAT

200 Ft. from N. Line

Ft. from S. Line

200 Ft. from E. Line

Ft. from W. Line

COMPLETED

ABANDONED			
			○

Location -----

Rig up -----

Drilling and Remarks:

RECORD

Cased ----- in., ----- ft.

Sand -----

Gas -----

Oil -----

Total Depth 2278

PRODUCTION

1st 24 hrs. Nat. -----

1st 24 hrs. after shot -----

Gas ----- Cu. Ft.

Dry Hole ✓ -----

Abandoned ✓ -----

Date

JAN 8 1927

CHAS. L. SHERWOOD

192

Scout