


Cowley

Form 51-5M-5-34-Palace

Map No. **KANSAS** Sec. 29 Twp. 31 R. 6E

Well No. L. Sitton et al. Farm _____
Lewis Prod. Company _____

NORTH

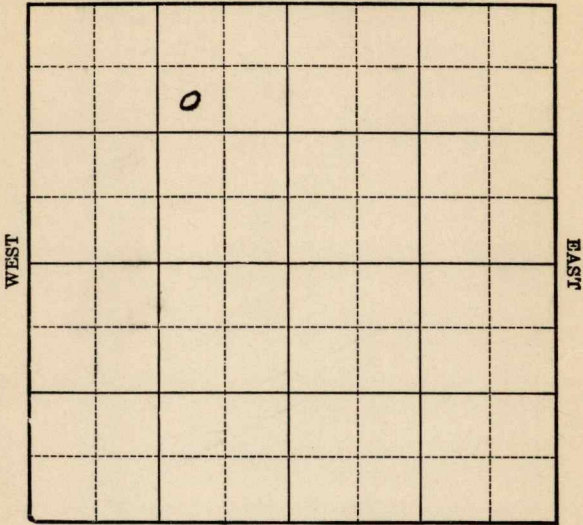

SOUTH

Location _____
Drilling Remarks _____

Rig Up _____
Drilling Remarks _____

RECORD

PRODUCTION

Cased _____ in. _____ ft.

Sand _____

Gas _____

Oil _____

Total Depth _____

1st 24 hrs. Nat. _____

1st 24 hrs. after shot _____

Gas _____ cu. ft.

Dry Hole _____

Abandoned _____

Cowley

Map No. **KANSAS** Sec. 29 Twp. 31 R. 6^E


Well No. 1 Sutton Est. Farm
Lewis Prod. Company

990 Ft. from N. Line

_____ Ft. from S. Line

990 Ft. from E. Line

_____ Ft. from W. Line

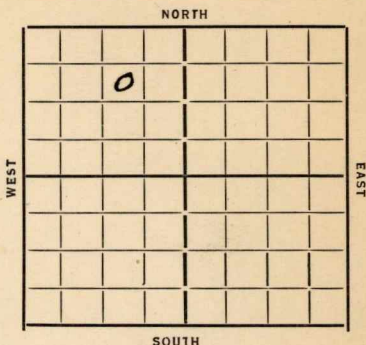

Date 1954

REPORT

<u>10/3</u>	<u>Rig</u>	
<u>10/11</u>	<u>dy 595</u>	<u>15" 450</u>
<u>10/18</u>	<u>" 1200</u>	
<u>10/25</u>	<u>" 2300</u>	
<u>10/31</u>	<u>Missed the sand TD 7925</u> <u>DTA</u>	

ABANDONED

Map No. 2 Sec. 29 Twp. 31 R. 6E

Well No. 1-Sutton Est.

Lewis prod Company

KANSAS Contractor

FIRST REPORTS

SECTION PLAT

990 Ft. from N. Line

..... Ft. from S. Line

990 Ft. from E. Line

..... Ft. from W. Line

	0		

Location.....

Rig up.....

Drilling and Remarks:

Rig

RECORD

Cased..... in., ft.

Sand.....

Gas.....

Oil.....

Total Depth.....

PRODUCTION

1st 24 hrs. Nat.....

1st 24 hrs. after shot.....

Gas..... Cu. Ft.

Dry Hole.....

Abandoned.....

Date

10-3-37 192.....

ORVAL MANNSCHRECK Scout

KANSAS

Map No. 2 Sec. 29 Twp. 31 R. 6 E

Well No. 1- Nitton est

Lewis Prod Company

Contractor

ABANDONED

SECTION PLAT

	0		

990 Ft. from N. Line

_____ Ft. from S. Line

990 Ft. from E. Line

_____ Ft. from W. Line

Location _____

Rig up _____

Drilling and Remarks:

Missed the sand.

NO + FI

RECORD

Cased _____ in., _____ ft.

Sand _____

Gas _____

Oil _____

Total Depth 2925

PRODUCTION

1st 24 hrs. Nat. _____

1st 24 hrs. after shot _____

Gas _____ Cu. Ft.

Dry Hole _____

Abandoned _____

Date

10-31-37 19

ORVAL MANNSCHECK

Scout