


Section 32 Township 18 Range 15-W

Well No. #1, Arnold

Company Coppinger etal

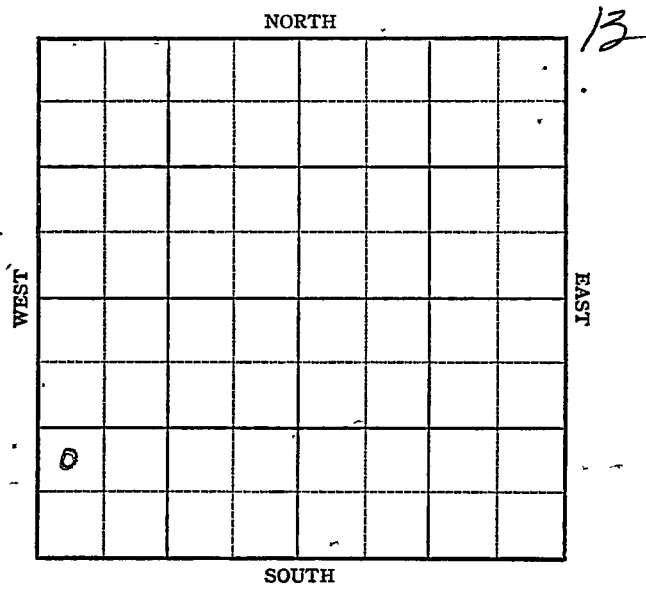

Sec. 32

Twp. 18

R. 15W

Well No. 1 Arnold

Farm

Coppinger ETAL

Company

Albert Pool


Ft. from N. Line

990 Ft. from S. Line

Ft. from E. Line

330 Ft. from W. Line

NORTH

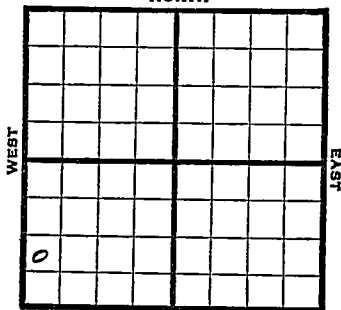

NW SW SW

SOUTH

1947

REPORT

- 1/2 8" @ 965'
Anhy 975'
Drlg 2238'
- 1/8 Land 3300'
Drlg 3573'
- 1/15 Cong 3579
Reagon 3596
- TD TD 3601'
5" @ 3598
RUST
- 1/21 TD 3638'
PB 3632
- 1/30 PB 3627
24 shots 3596-98
1 oil a day
- 2/5 " "
- 2/12 " "
- 2/19 " "
- 2/26 " "
- 3/4 PB 3627'
- 3/11 " "

OVER

3/18 PB 3617'

3/25 " "

...

4/2 Reagan 3596'
5" @ 3598'
Pump 40 Pot
36.0 Gr.
TD 3638'.

COMPLETED

Map No. K 73 Sec. 32 Twp. 18 R. 15W

Well No. 1 Arnold

Coppinger etal. Company

COMPLETE

NW SW SW

E 1, 2002

SECTION PLAT'

6			

_____ Ft. from N. Line

990 Ft. from S. Line

_____ Ft. from E. Line

330 Ft. from W. Line

Barton County

Location _____

Rig up _____

Drilling and Remarks:

Reagan 3596

5' 23594

Pump 40 R 8

360 92

RECORD

Cased _____ in., _____ ft.

Sand _____

Gas _____

Oil _____

Total Depth 3638

PRODUCTION

1st 24 hrs. Nat. _____

1st 24 hrs. after shot _____

Gas _____ Cu. Ft.

Dry Hole _____

Abandoned _____

Date

APR 2 1947 19

S. J. LEWIS Scout