

KANSAS

Barton

Sec. 32 Twp. 18 R. 15-W

Well No. #3 Arnold Farm

Coppinger et al Company

Albert Pool


Ft. from N. Line

330' Ft. from S. Line

Ft. from E. Line

990' Ft. from W. Line

SE SW SW

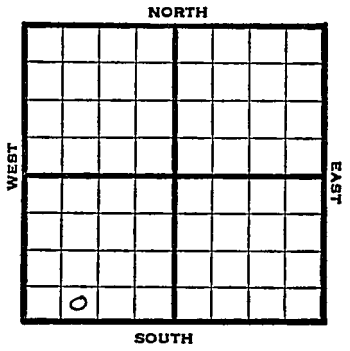

1947

Elev. 2008' REPORT

11/12

Location

11/19

"

11/25

8" @ 1018'
Drlg. 3409'

12/3

Arbuckle 3623'
Basal 3633'
TD 3636'
5" @ 3630'
RUST

12/10

Swb. 80 bbls. oil 12 hrs.

12/30

Basal 3633'
5" @ 3630'
Pump 100 Pot
36.0 Gr.
TD 3636'

COMPLETED

Map No. 73 Sec 32 Twp. 18 R. 15W

Well No. 3 Arnold

Coppinger et al. Company

COMPLETE Contractor

SE SW SW

E. 2008

SECTION PLAT

_____ Ft. from N. Line

330 Ft. from S. Line

_____ Ft. from E. Line

990 Ft. from W. Line

Barton County

Location _____

Rig up _____

Drilling and Remarks:

Base 13623

5" @ 3620

Pump 100 Pst

36 2/3

RECORD

Cased _____ in., _____ ft.

Sand _____

Gas _____

Oil _____

Total Depth 3626

PRODUCTION

1st 24 hrs. Nat. _____

1st 24 hrs. after shot _____

Gas _____ Cu. Ft.

Dry Hole _____

Abandoned _____

Date

DEC 30 1947

19

S. J. LEWIS

Scout

Map No. _____ Sec. 32 Twp. 18 R. 15W

Well No. 3 Arnold

Coppinger etal. Company

FIRST REPORT Contractor

SE SW SW

SECTION PLAT

_____ Ft. from N. Line

330 Ft. from S. Line

_____ Ft. from E. Line

990 Ft. from W. Line

Barton County

Location X

Rig up _____

Drilling and Remarks:

RECORD

Cased _____ in., _____ ft.

Sand _____

Gas _____

Oil _____

Total Depth _____

PRODUCTION

1st 24 hrs. Nat. _____

1st 24 hrs. after shot _____

Gas _____ Cu. Ft.

Dry Hole _____

Abandoned _____

Date

NOV 12 1947 19

S. J. LEWIS

Scout