


Map No. KANSAS Sec. 21 Twp. 30 R. 11
 Well No. 1 - Fleak Farm
Harvey et al Company

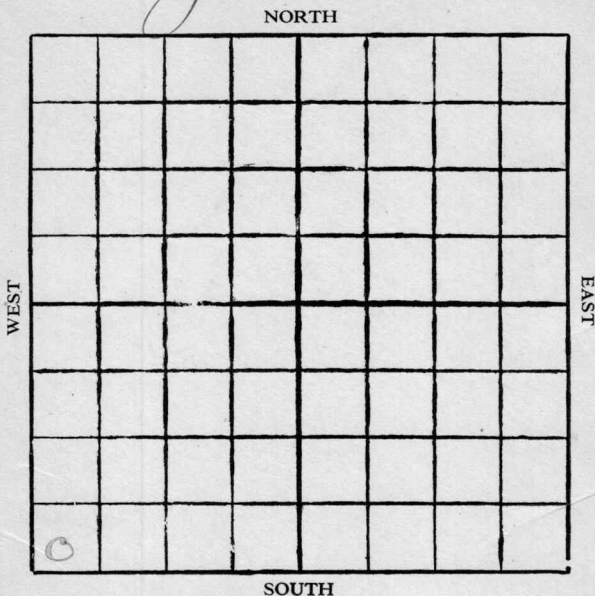

Location

Drilling Remarks

Rig Up

Drilling Remarks

.....

.....

RECORD

Cased in. ft.

Sand

Gas

Oil

Total Depth

PRODUCTION

1st 24 hrs. Nat.

1st 24 hrs. after shot

Gas cu. ft.


Dry Hole

Abandoned

KANSAS

Map No. _____ Sec. 21 Twp. 30 R. 11Well No. 1-Fleak Farm _____Harvey et al Company _____

NORTH

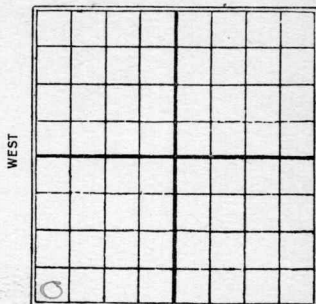

WEST

EAST

SOUTH

_____ Ft. from N. Line

250 Ft. from S. Line

_____ Ft. from E. Line

250 Ft. from W. Line1928

Date

REPORT

3/8 Machine3/16 _____3/22 Drly 4003/29 " 7004/5 _____4/12 _____4/19 show oil 1250N. & A. 1575T.D. 1575'

9 KANSAS
 Map No. _____ Sec. 21 Twp. 30 R. 11

Well No. 1

Harvey et al Company

_____ Contractor

FIRST REPORTS

_____ Ft. from N. Line

250 _____ Ft. from S. Line

_____ Ft. from E. Line

250 _____ Ft. from W. Line

SECTION PLAT

Location _____

Rig up _____

Drilling and Remarks:

RECORD

Cased _____ in., _____ ft.

Sand _____

Gas _____

Oil _____

Total Depth _____

PRODUCTION

1st 24 hrs. Nat. _____

1st 24 hrs. after shot _____

Gas _____ Cu. Ft.

Dry Hole _____

Abandoned _____

Date

MAR 8 1928

CHAS. L. SHERWOOD

192

Scout

9 KANSAS 21 30 R. 11
 Map No. Sec. Twp. R.

Well No. 1 7 leak
 Harvey et al Company
 Contractor

COMPLETED

Ft. from N. Line

750 Ft. from S. Line

Ft. from E. Line

750 Ft. from W. Line

ABANDONED

SECTION PLAT

Location

Rig up

Drilling and Remarks:

Show at 1750'

Show 1575

RECORD

Cased in., ft.

Sand

Gas

Oil

Total Depth 1575

PRODUCTION

1st 24 hrs. Nat.

1st 24 hrs. after shot

Gas Cu. Ft.

Dry Hole

Abandoned

Date

APR 19 1928

192

CHAS. L. SHERWOOD

Scout