

KANSAS


FORM 51 IOM 12-46 PETROL

Barton county

Section 32 Township 18 Range 15-W

Well No. #1, Tullis

Company Bay Pet.

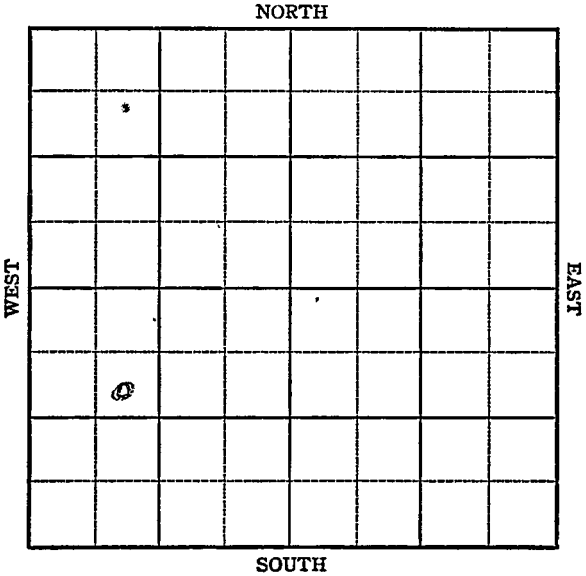

Sec. 32 Twp. 18 R. 15W

Well No. 1 Tullis Farm  
Bay Pet. Company

Albert Pool


990 Ft. from N. Line

Ft. from S. Line

Ft. from E. Line

990 Ft. from W. Line

SE NW SW

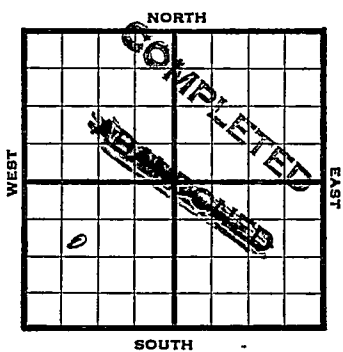

1947 Elev. 1985' REPORT

1/2 RUR  
1/8 Surface hole

1/15 8" @ 1008  
Drlg 2690'

1/21 Lans 3298  
Cong 3566  
Basal 3578  
TD 3580'  
5" @ 3579  
RUST

1/30 TD 3581'

2/5 TD 3583'  
Swab 9 oil  
PH 2 hrs

2/12 " "

2/19 " "

2/26 " "

3/4 " "

3/11 TD 3583'

COMPLETED

(over)

3/26 Basal 3578'  
5" @ 3579'  
Pump 150 oil & 25\$ w/pot  
36.0 Gr.  
TD 3583.

**COMPLETED**

Map No. 73 Sec. 32 Twp. 18 R. 15W

Well No. 1 Tullis

Bay Pet. Company

**FIRST REPORT**

Contractor

SE NW SW

990 Ft. from N. Line

\_\_\_\_\_ Ft. from S. Line

\_\_\_\_\_ Ft. from E. Line

990 Ft. from W. Line

**SECTION PLAT**


Barton County

Location \_\_\_\_\_

Rig up \_\_\_\_\_

Drilling and Remarks:

R U R

**RECORD**

Cased \_\_\_\_\_ in., \_\_\_\_\_ ft.

Sand \_\_\_\_\_

Gas \_\_\_\_\_

Oil \_\_\_\_\_

Total Depth \_\_\_\_\_

**PRODUCTION**

1st 24 hrs. Nat. \_\_\_\_\_

1st 24 hrs. after shot \_\_\_\_\_

Gas \_\_\_\_\_ Cu. Ft.

Dry Hole \_\_\_\_\_

Abandoned \_\_\_\_\_

Date

JAN 2 1947 19

S. J. LEWIS Scout

Kansas

Map No. K73 Sec. 32 Twp. 18 R. 15WWell No. 1 TullisBay Pet. Company

COMPLETE

Contractor

SE NW SW

E. 1985  
SECTION PLAT990 Ft. from N. Line       Ft. from S. Line       Ft. from E. Line990 Ft. from W. Line


Barton County

Location \_\_\_\_\_

Rig up \_\_\_\_\_

Drilling and Remarks:

Basal 8578'5' @ 3579Prod. 1500 oil +25% W.P.D.96' @

## RECORD

Cased \_\_\_\_\_ in., \_\_\_\_\_ ft.

Sand \_\_\_\_\_

Gas \_\_\_\_\_

Oil \_\_\_\_\_

Total Depth 8578'

## PRODUCTION

1st 24 hrs. Nat. \_\_\_\_\_

1st 24 hrs. after shot \_\_\_\_\_

Gas \_\_\_\_\_ Cu. Ft.

Dry Hole \_\_\_\_\_

Abandoned \_\_\_\_\_

Date

MAR 26 1947 19

S. J. LEWIS

Scout