


Section 4 Township 20 Range 10-W

Well No. #1 Linville

Company Phoenix Drlg.

NORTH Semi-Wildcat

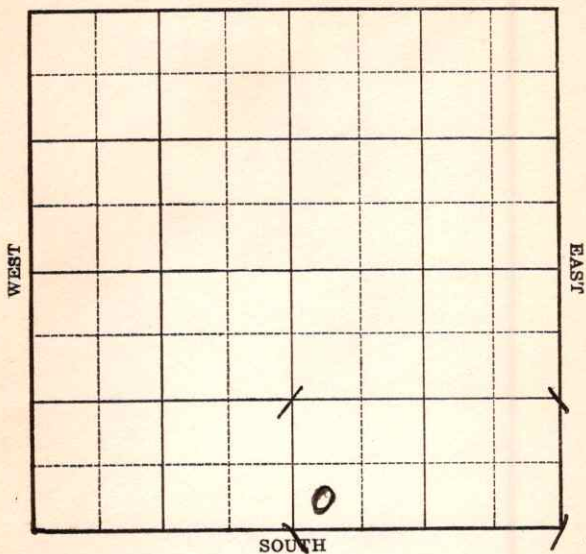

Sec. 4 Twp. 20 R. 10-W

Well No. #1 Linville Farm \_\_\_\_\_

Phoenix Drlg. Company \_\_\_\_\_


**(Semi-Wildcat)**

\_\_\_\_\_ Ft. from N. Line

330 Ft. from S. Line

\_\_\_\_\_ Ft. from E. Line

330 Ft. from W. Line

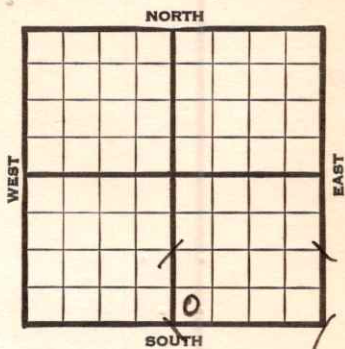

1939	REPORT
6/14	Cable.
6/23	Spud 35.
6/29	15" - 142'
7/6	12" - 490' Drlg. 1720'
7/13	10" - 1823' Drlg. 2135'
7/20	8 1/4" - 2338' Drlg. 2405'
7/27	8 1/4" - 2457' T.D. 2625' C.O.
8/3	8" - 2661' <b>Topeka 2650'</b>
	Drlg. 3075'
8/4	6" 3038 <b>Top Lansing 3078</b>
	Show oil 3155-60
	1/2 bailer water per hour 3160-65
	TD 3165 Filled up 400' oil 24 hrs.
	Think water exhausting Will lower casing thru shale break to 3140
	Est. 15 bbl well May acidize (Tel)
8/10	6-5/8" - 3078' Drlg. 3201'
8/11	<b>Conglomerate 3350</b> Dlg. 3355 no show (Tel)
8/17	6" - 3171' <b>Simp. 3375'</b>
	<b>Arb. 3388'</b> Drlg. 3395'

**OVER**

1939  
 8/24 H.F.W. 3396'  
 TD 3400' SD.  
 8/31 " " "  
 9/7 " " "  
 9/14 " " "  
 9/21 " " "  
 9/28 " " "  
 10/5 P. B. Shut down.  
 10/12 P.B. 3185' 1000 acid.  
 Swab 40 bbls. fluid 12 hours.  
 50% water.  
 10/19 2000 acid. Pump 30 oil & 15  
 water in 12 hours.  
 10/26 No report.  
 11/2 Pump 11 oil 8 water 12 hours.  
 11/8 Lans. 3078'  
 Arb. 3388'  
 T.D. 3400'  
 P. B. to 3185'  
 6" - 3171'  
 Pump 15 bbls.

COMPLETED

Map No. 46 Sec. 4 Twp. 20 R. 10WWell No. 1 Linville

Phoenix Drlg. Company

Contractor

## FIRST REPORT

## SECTION PLAT

SW SE

\_\_\_\_\_ Ft. from N. Line

330 Ft. from S. Line

\_\_\_\_\_ Ft. from E. Line

330 Ft. from W. Line

		MC.	

SEMI-WILDCAT

Location \_\_\_\_\_

Rig up \_\_\_\_\_

Drilling and Remarks:

Cable

## RECORD

Cased \_\_\_\_\_ in., \_\_\_\_\_ ft.

Sand \_\_\_\_\_

Gas \_\_\_\_\_

Oil \_\_\_\_\_

Total Depth \_\_\_\_\_

## PRODUCTION

1st 24 hrs. Nat. \_\_\_\_\_

1st 24 hrs. after shot \_\_\_\_\_

Gas \_\_\_\_\_ Cu. Ft.

Dry Hole \_\_\_\_\_

Abandoned \_\_\_\_\_

Date

JUN 14 1939

19

S. J. LEWIS

Scout

Rice

Map No. 46 Sec. 4 Twp. 20 R. 10W

Well No. 1 Linville

Phoenix Drilling Company

Contractor

COMPLETED

SECTION PLAT

SW SE


\_\_\_\_\_ Ft. from N. Line

330 Ft. from S. Line

\_\_\_\_\_ Ft. from E. Line

330 Ft. from W. Line

SEMI-WILDCAT

Location \_\_\_\_\_

Rig up \_\_\_\_\_

Drilling and Remarks:

*Loss 3078*  
*Cur 3388.*  
*P.B 3185.*  
*6" @ 3171.*  
*Pump 15886*

RECORD

Cased \_\_\_\_\_ in., \_\_\_\_\_ ft.

Sand \_\_\_\_\_

Gas \_\_\_\_\_

Oil \_\_\_\_\_

Total Depth 3400

PRODUCTION

1st 24 hrs. Nat. \_\_\_\_\_

1st 24 hrs. after shot \_\_\_\_\_

Gas \_\_\_\_\_ Cu. Ft.

Dry Hole \_\_\_\_\_

Abandoned \_\_\_\_\_

Date

NOV 8 1939 19

S. J. LEWIS

Scout