


Section 32 Township 18 Range 15W

Well No. #1 Anderson

Company Harms & Knight

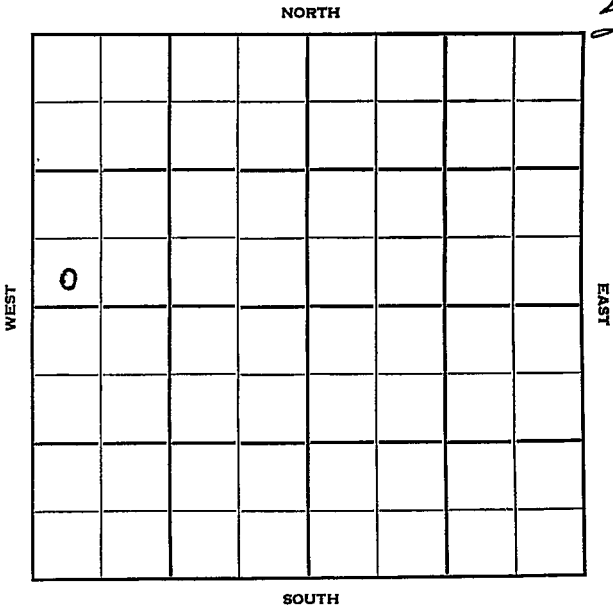

Sec. 32 Twp. 18 R. 15W

Well No. #1 Anderson Farm

Harms & Knight Company

Harms & Knight Contractor
Otis-Albert Pool


_____ Ft. from N. Line

330 Ft. from S. Line

_____ Ft. from E. Line

330 Ft. from W. Line

SW SW NW

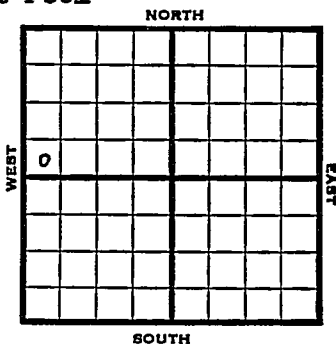

Elev. 1962' REPORT

1953

6/3 C&P

6/24 Drlg 3375'

7/1 Heeb 3187, Tor 3210, Lans 3257. Cong
 3534, Reagan 3545
 RTD 3558'
 5" @ 3552'

7/8 NR

7/22 NR

8/12 Spud 6-12-53
 Oil Well
 TD 3558'
 8" @ 975'
 Heeb 3187, Tor 3210, Lans 3257, Cong
 3534, Regan 3210, L
 TD 3558'
 5" @ 3552'
 CO to 3558'
 FU 250' oil 36 hr. S/ 4 goph sd-oil.
 frac.
 S/ 16 boph.
 Comp. 45 bopd.

COMPI ETED

County Barton State Kansas

Sec. 32 (Blk. Twp.) 18 (Sur. Rge.) 15W Map No.

Operator Harms & Knight

Well No. 1 Farm Anderson

Elev. Location SW SWNW

330 Ft. From S Line NW

330 Ft. From W Line Quarter

1st. Report JUN 3 1953

Completion

Remarks

Harms & Knight - Contr.

Spudding Date

Drig. Data Otis-Albert Pool

Cellar & pits

