

Sec. 32 Twp. 18 R. 15-W

Well No. #1 Anderson Farm

E. R. Rabon et al Company

(Albert)


330 Ft. from N. Line

Ft. from S. Line

660 Ft. from E. Line

Ft. from W. Line

Elev. 1918

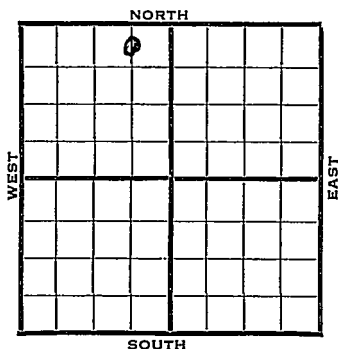

1940	REPORT
7/24	Cable.
8/2	Standard rig.
8/8	" "
8/14	" "
8/22	15" - 37'
8/29	TD 350' SD.
9/5	12" - 370' Anhy 913'
	10" - 913' Drlg. 1630'
9/12	Shut down.
9/19	Drlg. 3115'
9/26	7" - 3239' H.F.W. 3250-55'
	3260' U.R. 7" .
10/3	Lansing 3238' HFW 3289-95'
	7" - 3320' HFW 3323'
	U.R. 7" at 3390'
10/10	7" - 3381' Basal sand 3483'
	U.R. 7" .
10/17	7" - 3480' T.D. 3514'
	3½ M gas. Shut down.
10/24	" " " "
	OVER

1940

10/31 P.B. 3509' Shot 30 qts.
15 M gas, SO & W.
P.B.

11/6 Basal 3480'
7" - 3480'
T.D. 3514'
P.B. to 3509'
Shot 30 qts.
5,328,000 gas.

COMPLETED

Map No. _____ Sec. 32 Twp. 18 R. 15WWell No. 1 AndersonE. R. Rabon etal

Company

Contractor

FIRST REPORT**C N L NE NW**330 Ft. from N. Line

_____ Ft. from S. Line

660 Ft. from E. Line

_____ Ft. from W. Line

ALBERT POOL**SECTION PLAT**

Location _____

Rig up _____

Drilling and Remarks:

Cable**RECORD**

Cased _____ in., _____ ft.

Sand _____

Gas _____

Oil _____

Total Depth _____

PRODUCTION

1st 24 hrs. Nat. _____

1st 24 hrs. after shot _____

Gas _____ Cu. Ft.

Dry Hole _____

Abandoned _____

Date

Jul 24 1940 19**S. J. LEWIS**

Map No. 73 Sec. 32 Twp. 18 R. 15WWell No. 1 AndersonE. R. Rabon etal

Company

Contractor

COMPLETED

C N L N E W

330 Ft. from N. Line

_____ Ft. from S. Line

660 Ft. from E. Line

_____ Ft. from W. Line

SECTION PLAT

ALBERT POOL

Location _____

Rig up _____

Drilling and Remarks:

*Basal @ 3480'**7" @ 3480'**P/B 3509**20 gts.**5,328,000 Gas***RECORD**

Cased _____ in., _____ ft.

Sand _____

Gas _____

Oil _____

Total Depth 3514**PRODUCTION**

1st 24 hrs. Nat. _____

1st 24 hrs. after shot _____

Gas _____ Cu. Ft.

Dry Hole _____

Abandoned _____

Date

NOV 6 1940 19

S. J. LEWIS Scout