


Section 3 Township 20 Range 10-W

Well Number 3 Proffitt

Company Sinclair-Prairie

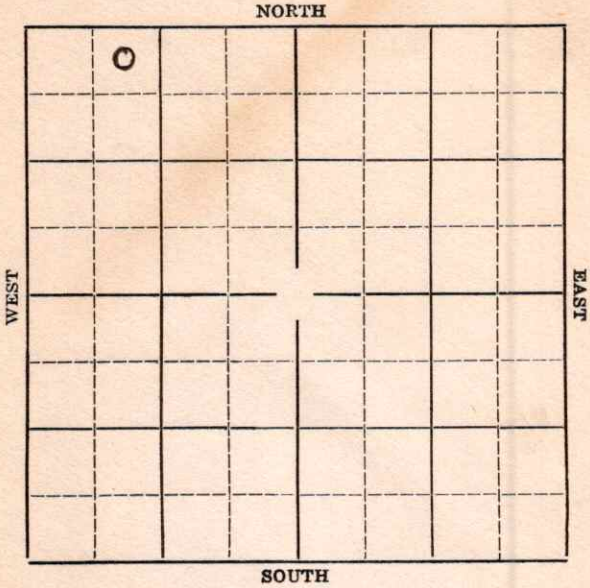


KANSAS

Rice

Sec. 3 Twp. 20 R. 10-WWell No. #3 Proffitt FarmSinclair-Prairie Company330 Ft. from N. Line Ft. from S. Line Ft. from E. Line990 Ft. from W. Line

Elev. 1794

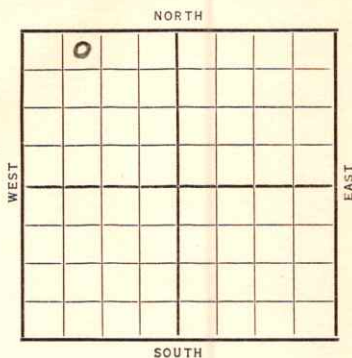~~D437~~

REPORT

3/3 Rigging up

3/11 12" @ 208'. Drlg. 1850'.

3/18 Drlg. 3050'.

3/25 Sil. 3327' set 7". RUST.

3/31 Sil. 3327'.

T. D. 3332'.

Potential 1437 natural.

COMPLETED

Map No. 46 Sec. 3 Twp. 20 R. 10W

Well No. 3 Proffitt

Sinclair-Prairie Company

Contractor

SECTION PLAT

0			

330 Ft. from N. Line

_____ Ft. from S. Line

_____ Ft. from E. Line

990 Ft. from W. Line

FIRST REPORT

Location _____

Rig up _____

Drilling and Remarks:

Rigging up

RECORD

Cased _____ in., _____ ft.

Sand _____

Gas _____

Oil _____

Total Depth _____

PRODUCTION

1st 24 hrs. Nat. _____

1st 24 hrs. after shot _____

Gas _____ Cu. Ft.

Dry Hole _____

Abandoned _____

Date

MAR 3 1937 19

S. J. LEWIS Scout

KANSAS *Rice*Map No. _____ Sec. 3 Twp. 20 R. 10WWell No. 3 ProffittSinclair Prairie Company

Contractor _____

SECTION PLAT

0			

330 Ft. from N. Line

_____ Ft. from S. Line

_____ Ft. from E. Line

990 Ft. from W. Line**COMPLETED**

Location _____

Rig up _____

Drilling and Remarks:

*Sil 3327**Potential**1437 natural***RECORD**

Cased _____ in., _____ ft.

Sand _____

Gas _____

Oil _____

Total Depth 3332**PRODUCTION**

1st 24 hrs. Nat. _____

1st 24 hrs. after shot _____

Gas _____ Cu. Ft.

Dry Hole _____

Abandoned _____

Date

MAR 31 1937

19

S. J. LEWIS Scout