


Map No. KS Sec. 21 Twp. 30 R. 11E

Well No. 1-Flask Farm \_\_\_\_\_  
York State Oil Company

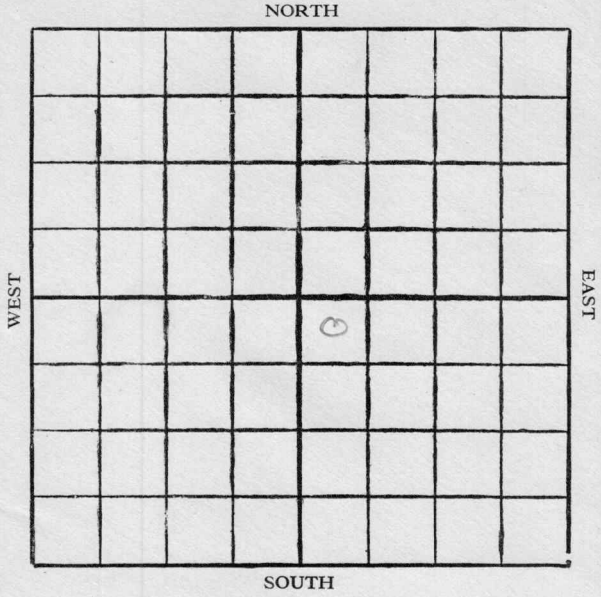

Location .....

Drilling Remarks

.....

.....

**RECORD**

Cased ..... in. .... ft.

Sand .....

Gas .....

Oil .....

Total Depth .....

Rig Up .....

Drilling Remarks

.....

.....

**PRODUCTION**

1st 24 hrs. Nat. ....

1st 24 hrs. after shot .....

Gas ..... cu. ft.

Dry Hole .....

Abandoned .....



Map No. 9 KANSAS Sec. 21 Twp. 30 R. 11<sup>W</sup>

Well No. 1 21

York's State Oil Co Company

Contractor

FIRST REPORTS

SECTION PLAT

250 Ft. from N. Line

\_\_\_\_\_ Ft. from S. Line

\_\_\_\_\_ Ft. from E. Line

250 Ft. from W. Line

COMPLETED

		0	

Location \_\_\_\_\_

Rig up \_\_\_\_\_

Drilling and Remarks:

100/15 Bb.

RECORD

Cased \_\_\_\_\_ in., \_\_\_\_\_ ft.

Sand 1232-1257

Gas \_\_\_\_\_

Oil \_\_\_\_\_

Total Depth 1257

PRODUCTION

1st 24 hrs. Nat. \_\_\_\_\_

1st 24 hrs. after shot \_\_\_\_\_

Gas \_\_\_\_\_ Cu. Ft.

Dry Hole \_\_\_\_\_

Abandoned \_\_\_\_\_

Date

JAN 8 1927

CHAS. L. SHERWOOD

192

Scout