

KANSAS


FORM 51 5M 11-44 PETROL

Barton County

Section 33 Township 18 Range 15W

Well No. #1 Bird

Company Nadel & Gussman

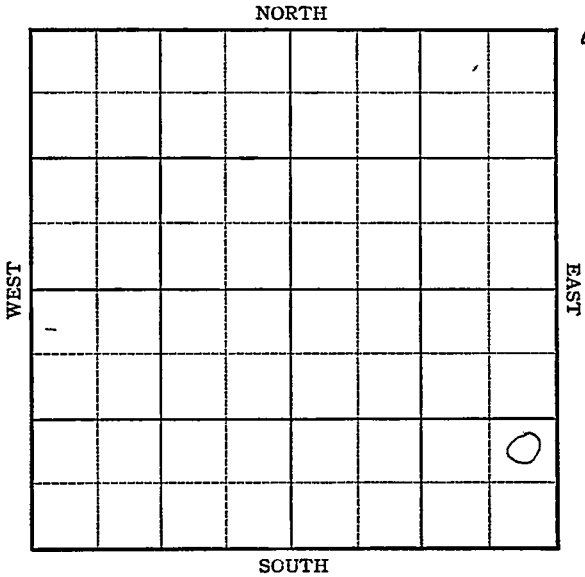

Sec. 33 Twp. 18S R. 15W

Well No. #1 Bird Farm _____

Nadel & Hussman Company


NE SE SE

_____ Ft. from N. Line

990 Ft. from S. Line

330 Ft. from E. Line

_____ Ft. from W. Line

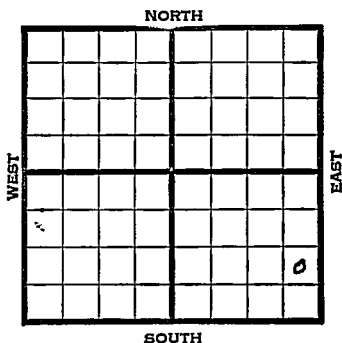

July, 1925

1945

REPORT

4-4 Rigging up rotary.
 4/12 13" @ 100
 Anhy 894
 8" @ 894 WOC
 4/20 Drlg. 2780'
 4/27 Lans 3215
 Bard Sd 3482
 TD 3488
 5" @ 3484' RUST
 5/3 TD 3515 5 M Gas.
 5/10 TD 3535
 10 qts.
 Flow 4 oil per hr 8 hrs.
 5/17 " " " " " "
 5/24 " " " " " "
 5/31 " " " " " "
 6/8 " " " " " "
 6/20 Basal Sd 3482
 5" @ 3482
 TD 3535
 10 qts. Pump. 100 Pot.
 Grav. 36.6

COMPLETED

Kansas Pool Name Bird

Map No. _____ Sec. 33 Twp. 18 R. 15W

Well No. 1 Bird

Nadel & Gussman Company

COMPLETED Contractor

NE SE SE

E. 1, 1925
SECTION PLAT

			0

_____ Ft. from N. Line

990 Ft. from S. Line

330 Ft. from E. Line

_____ Ft. from W. Line

Barton County

Location _____

Rig up _____

Drilling and Remarks:

Basal @ 13482

5' @ 3484

109 to Pump

100 P.S.

36 1/2 Gr

RECORD

Cased _____ in., _____ ft.

Sand _____

Gas _____

Oil _____

Total Depth 3535

PRODUCTION

1st 24 hrs. Nat. _____

1st 24 hrs. after shot _____

Gas _____ Cu. Ft.

Dry Hole _____

Abandoned _____

Date

JUN 20 1945

19

S. J. LEWIS Scout