

Map No. Can Sec. 34 Twp. 27 R. 7

Well No. 2 Blank Farm

Greenland Out Company

Manhattan ^{NORTH} oil

WEST

EAST

SOUTH

A

Location

Drilling Remarks

Rig Up_____

Drilling Remarks

RECORD

Cased_____in. _____ft.

Sand

Gas

Oil

Total Depth _____

PRODUCTION

1st 24 hrs. Nat.

1st 24 hrs. after shot -----

Gas _____ cu. ft.

Dry Hole

Abandoned

Map No. 1 Kansas Sec. 34 Twp. 27 R. 7Well No. 2 Blank Farm~~Greenland Oil~~ Company860 Manhattan Oil NORTH~~760~~~~790~~ Ft. from N. Line

Ft. from S. Line


Ft. from E. Line

Ft. from W. Line

250

~~330~~

Ft. from W. Line

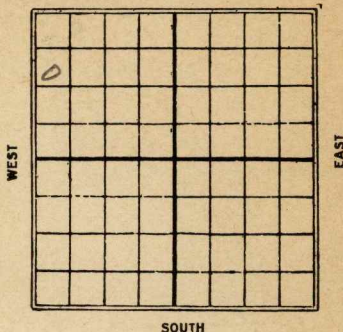

Date

REPORT

1925

12/10

12/17

12/23

12/31

1926

1/8

1/14

1/20

1/27

2/4

2/10

2/17

2/24

3/5

3/10

3/18

3/25

4/1

4/7

4/14

4/21

Fishing

Drilling

Abandoned

2680

2695

2820

1515

1610

2200

2530

Butter Co

Map No. KANSAS Sec. 34 Twp. 27 R. 7Well No. 2 BluntButter Land Oil Co Company

Contractor

SECTION PLAT

990 Ft. from N. Line

Ft. from S. Line

Ft. from E. Line

330 Ft. from W. Line

FIRST REPORTS

o			

Location Timber

Rig up

Drilling and Remarks:

RECORD

Cased _____ in., _____ ft.

Sand _____

Gas _____

Oil _____

Total Depth _____

PRODUCTION

1st 24 hrs. Nat. _____

1st 24 hrs. after shot _____

Gas _____ Cu. Ft.

Dry Hole _____

Abandoned _____

Date

DEC 10 1925

192

CHAS. L. SHERWOOD

Scout

10 **KANSAS** Sec. *34* Twp. *27* R. *7*

Well No. *2* *Blunt*
Greenland Oil Co. Company

Contractor

CORRECTION

760 Ft. from N. Line

----- Ft. from S. Line

----- Ft. from E. Line

250 Ft. from W. Line

SECTION PLAT

<i>10</i>			

Location -----

Rig up -----

Drilling and Remarks:

2500

*Chg location
to above.*

RECORD

Cased ----- in., ----- ft.

Sand -----

Gas -----

Oil -----

Total Depth -----

PRODUCTION

1st 24 hrs. Nat. -----

1st 24 hrs. after shot -----

Gas ----- Cu. Ft.

Dry Hole -----

Abandoned -----

Date

JAN 14 1926

CHAS. L. SHERWOOD

Scout

Map No. *K10* **KANSAS** Sec. *34* Twp. *27* R. *7*

Well No. *2* *Blunt*

Sibben Land and Co Company

Contractor

CORRECTION

860 Ft. from N. Line

Ft. from S. Line

Ft. from E. Line

250 Ft. from W. Line

SECTION PLAT

Location *timbers*

Rig up

Drilling and Remarks:

Get Mea Luben
changed to above

RECORD

Cased _____ in., _____ ft.

Sand _____

Gas _____

Oil _____

Total Depth _____

PRODUCTION

1st 24 hrs. Nat. _____

1st 24 hrs. after shot _____

Gas _____ Cu. Ft.

Dry Hole _____

Abandoned _____

Date

JAN 20 1926

192

CHAS. L. SHERWOOD

Scout

K10 **KANSAS** Sec. *34* Twp. *27* R. *7*

Well No. *Blunt*
Manhattan Oil Co. Company

Contractor

SECTION PLAT


----- Ft. from N. Line

----- Ft. from S. Line

----- Ft. from E. Line

----- Ft. from W. Line

CORRECTION

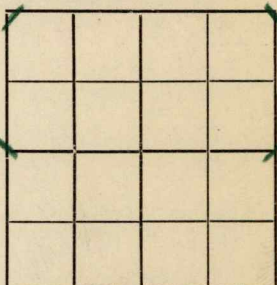

Location -----

Rig up -----

Drilling and Remarks:

*Chg ownership
on this Lease
to above.*

RECORD

Cased ----- in., ----- ft.

Sand -----

Gas -----

Oil -----

Total Depth -----

PRODUCTION

1st 24 hrs. Nat. -----

1st 24 hrs. after shot -----

Gas ----- Cu. Ft.

Dry Hole -----

Abandoned -----

Date

FEB 10 1926

192

CHAS. L. SHERWOOD

Scout

Butler
 Map No. *K10* **KANSAS** Sec. *34* Twp. *27* R. *7*

Well No. *2* *Blunt*
manhattan oil Co Company

Contractor

COMPLETED

SECTION PLAT

860

Ft. from N. Line

Ft. from S. Line

Ft. from E. Line

250

Ft. from W. Line

ABANDONED

G			

Location

Rig up

Drilling and Remarks:

*sd y shal 2735-**2740**1221**2820*

RECORD

Cased _____ in., _____ ft.

Sand _____

Gas _____

Oil _____

Total Depth *2820*

PRODUCTION

1st 24 hrs. Nat. _____

1st 24 hrs. after shot _____

Gas _____ Cu. Ft.

Dry Hole ☒Abandoned ☒

Date

APR 21 1926

CHAS. L. SHERWOOD

192

Scout