


Map No. 15 Sec. 30 Twp. 30 R. 11 E

Well No. 1-Beatty Farm
Frazier et al Company

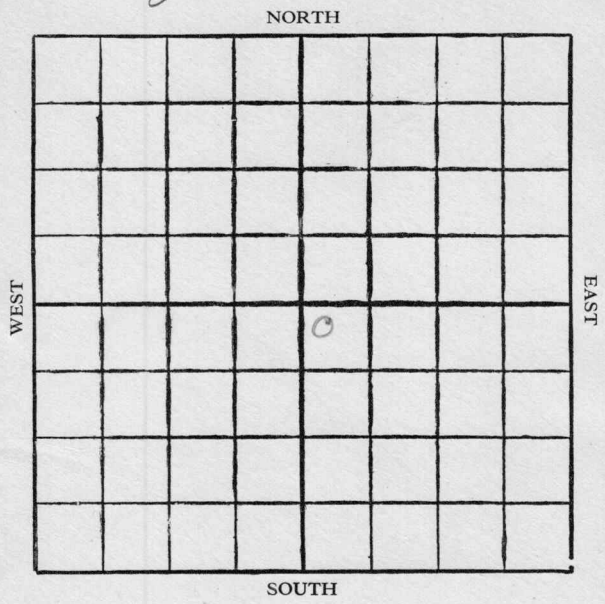

Location

Drilling Remarks

.....

.....

Rig Up.....

Drilling Remarks

.....

.....

RECORD

Cased..... in. ft.

Sand

Gas

Oil

Total Depth.....

PRODUCTION

1st 24 hrs. Nat.....

1st 24 hrs. after shot.....

Gas..... cu. ft.

Dry Hole.....

Abandoned.....

ELK

Map No. Kansas Sec. 30 Twp. 30 R. 11


Well No. 1 Beatty Farm
Frazier et al Company

200 Ft. from N. Line

..... Ft. from S. Line

..... Ft. from E. Line

200 Ft. from W. Line

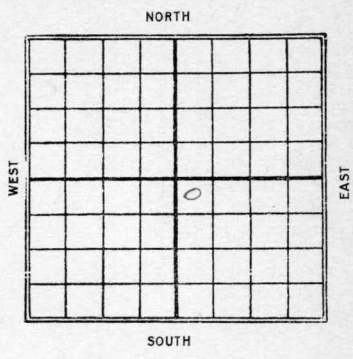

Date
1927

REPORT

1/8 Sand 1865-1866 277 lbs

9 KANSAS *666*
Map No. _____ Sec. *30* Twp. *30* R. *11* *E*

Well No. *1 Beatty*

Kazien et al Company

Contractor

FIRST REPORTS

SECTION PLAT

200 Ft. from N. Line

_____ Ft. from S. Line

_____ Ft. from E. Line

200 Ft. from W. Line

		o	

COMPLETED

Location _____

Rig up _____

Drilling and Remarks:

Gas well.

RECORD

Cased _____ in., _____ ft.

Sand *1865-1866*

Gas _____

Oil _____

Total Depth *1866*

PRODUCTION

1st 24 hrs. Nat. _____

1st 24 hrs. after shot _____

Gas *2* *AT* _____ Cu. Ft.

Dry Hole _____

Abandoned _____

Date

JAN 8 1927

CHAS. L. SHERWOOD

192

Scout