

Map No. 15 Sec. 30 Twp. 30 R. 11E

Well No. 1- Collyer Farm
Penrock oil Company

NORTH

WEST

EAST

SOUTH

Location

Drilling Remarks

Rig Up.....

Drilling Remarks

RECORD

Cased.....in. ft.

Sand

Gas _____

Oil

Total Depth.....

PRODUCTION

1st 24 hrs. Nat.

1st 24 hrs. after shot.....

Gas..... cu. ft.

Dry Hole

Abandoned

ELK

Map No. Kansas Sec. 30 Twp. 30 R. 11E


Well No. 1 Collyer Farm
Pennock oil Company

660 Ft. from N. Line

_____ Ft. from S. Line

200 Ft. from E. Line

_____ Ft. from W. Line

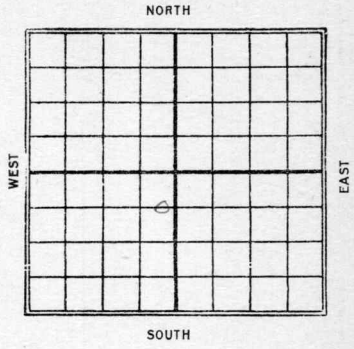

Date

REPORT

1927

1/8 Sand 1122-1128 220 bbls
32 Gravity

6615 30 30 11 E
 9 KANSAS
 Map No. _____ Sec. 30 Twp. 30 R. 11 E

Well No. 1 Collyer
 Kennocis oil Co _____ Company

 Contractor

FIRST REPORTS

660 _____ Ft. from N. Line

_____ Ft. from S. Line

200 _____ Ft. from E. Line

_____ Ft. from W. Line

COMPLETED

SECTION PLAT

	0		

Location _____

Rig up _____

Drilling and Remarks:

220 Bbs.

32 Gravity

RECORD

Cased _____ in., _____ ft.

Sand 1122-1128 _____

Gas _____

Oil _____

Total Depth 1128 _____

PRODUCTION

1st 24 hrs. Nat. _____

1st 24 hrs. after shot _____

Gas _____ Cu. Ft.

Dry Hole _____

Abandoned _____

Date

JAN 8 1927

CHAS. L. SHERWOOD

192

Scout