


Map No. Kansas Sec. 22 Twp. 27 R. 7

Well No. 2 Harris Farm

Mid-Kansas Company

NORTH

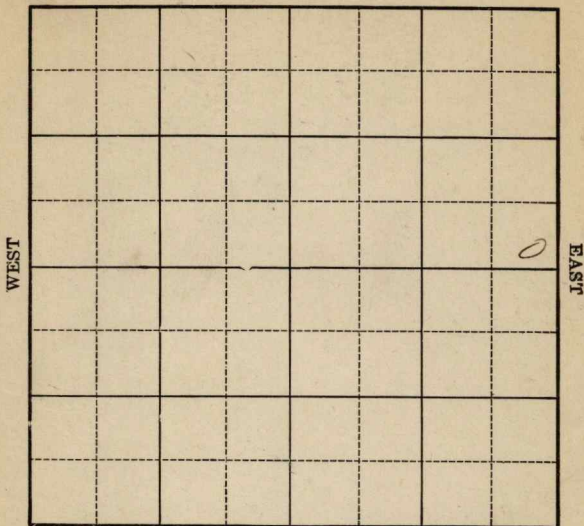

SOUTH

Location _____

Drilling Remarks _____

Rig Up _____

Drilling Remarks _____

RECORD

Cased _____ in. _____ ft.

Sand _____

Gas _____

Oil _____

Total Depth _____

PRODUCTION

1st 24 hrs. Nat. _____

1st 24 hrs. after shot _____

Gas _____ cu. ft.

Dry Hole _____

Abandoned _____

Butler

K10 KANSAS

22

Map No. _____ Sec. _____ Twp. 27 R. 7

Well No. 2 *Harris**Mid-Kan Gas*

Company _____

Contractor _____

FIRST REPORTS

SECTION PLAT

			X
			X
			X
			X

_____ Ft. from N. Line

330

_____ Ft. from S. Line

330

_____ Ft. from E. Line

_____ Ft. from W. Line

Location _____

Rig up _____

Drilling and Remarks:

Ho 2

RECORD

Cased _____ in., _____ ft.

Sand _____

Gas _____

Oil _____

Total Depth _____

PRODUCTION

1st 24 hrs. Nat. _____

1st 24 hrs. after shot _____

Gas _____ Cu. Ft.

Dry Hole _____

Abandoned _____

Date

MAY 19 1926

192

CHAS. L. SHERWOOD

Scout

Map No. _____ Sec. 22 Twp. 27 R. 7Well No. 2 HarrisMid-Kansas Company


Contractor _____

SECTION PLAT

_____ Ft. from N. Line

330 Ft. from S. Line330 Ft. from E. Line

_____ Ft. from W. Line

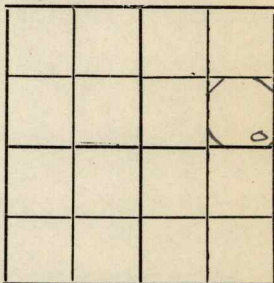COMPLETED

Location _____

Rig up _____

Drilling and Remarks:

120 gts
150 bbls

RECORD

Cased _____ in., _____ ft.

Sand 2689-2741

Gas _____

Oil _____

Total Depth _____

PRODUCTION

1st 24 hrs. Nat. _____

1st 24 hrs. after shot _____

Gas _____ Cu. Ft.

Dry Hole _____

Abandoned _____

water returned

Date

7/14 1926Sherwood
Scout