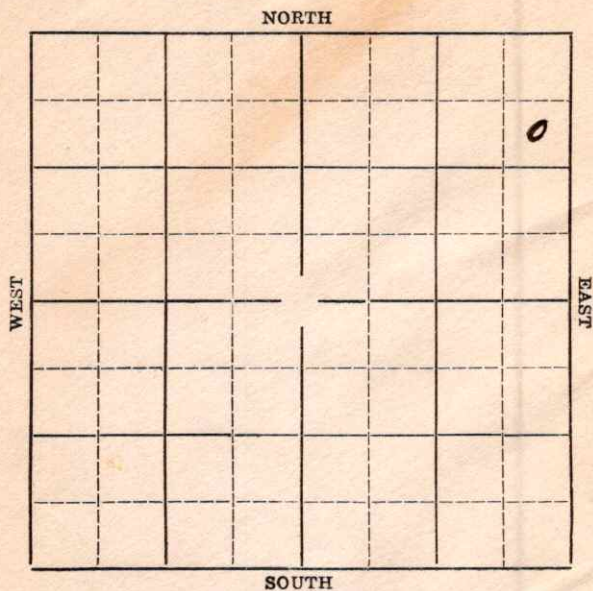



Section 4 Township 20 Range 10-WWell Number #3 C.A. WoodCompany Mid-Continent Petroleum Corp.

Sec. 4 Twp. 20 R. 10WWell No. #3 C.A. Wood FarmMid-Continent Petroleum Corp. Company990' Ft. from N. Line

Ft. from S. Line

330' Ft. from E. Line

Ft. from W. Line

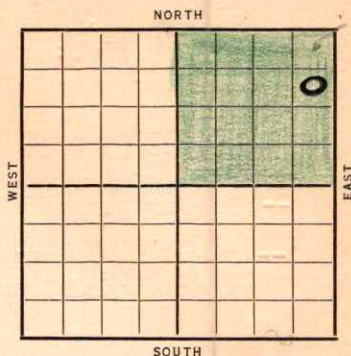Elev. 1795Date 1936

REPORT

10/7 Building rig.10/12 Drilling surface hole (Tel)10/15 Surface hole.10/22 Dlg. 2300 (Tel)10/29 Drlg. 2970'.10/31 Coring 3330 Nothing showing (Tel)

Running 13 feet lower than #1

11/2 Top Siliceous 3330

T.D. 3341 Some saturation

Will set pipe 3336 (Tel)

11/7 Will drill in Monday night (Tel)11/12 Drilled to T.D. 3345½From 3344-45½ filled up 550 feet oil
in 1 hr. and 50 minutesFilling up at rate of 250 feet oil
per hour (Tel)11/12 Filled up 1500 feet 10 hours Will
acidize with 2000 gallons (Telegram)11/14 Acidized with 2000 gallons acid

Will open and test Monday (Tel)

(OVER)

11/15--Top Siliceous 3330

T.D. 3345 $\frac{1}{2}$

Acidized 2,000 gallons acid

On Potential:

1st hour made 60 bbls.

2nd " " 50 "

Estimate 500 to 600 bbl. well (Tel)

11/16--24 hour potential 1179 bbls. (Telegram)

11/17--After 19th hour made 20% water
on potential gauge (Tel)

11/18 Sil. 3333 Pay 3344-45 $\frac{1}{2}$

T. D. 3345 $\frac{1}{2}$ '. 2000 acid.

Pot. 1179

COMPLETED

12/4/36--Retest 1443 barrels. (Telegram)

2/4-60 day retest 1089 bbls (Tel)

4/17--Field test 990 bbls. (Telegram)

10/6--Field test 330 bbls. (Tel)

KANSAS

Map No. 46 Sec. 4 Twp. 20 R. 10WWell No. 3 C C WoodMid-Continental & Pac. Company

Contractor

SECTION PLAT

			6

990 Ft. from N. Line

_____ Ft. from S. Line

320 Ft. from E. Line

_____ Ft. from W. Line

FIRST REPORT

Location _____

Rig up _____

Drilling and Remarks:

Building rig

RECORD

Cased _____ in., _____ ft.

Sand _____

Gas _____

Oil _____

Total Depth _____

PRODUCTION

1st 24 hrs. Nat. _____

1st 24 hrs. after shot _____

Gas _____ Cu. Ft.

Dry Hole _____

Abandoned _____

Date

OCT 7 1936

19

S. J. LEWIS

Scout

KANSAS

Map No. 46 Sec. 4 Twp. 20 R. 10WWell No. 3 Wood.Mid-Continent Petroleum Company

Contractor

SECTION PLAT

			0

990 Ft. from N. Line

_____ Ft. from S. Line

330 Ft. from E. Line

_____ Ft. from W. Line

COMPLETED

Location _____

Rig up _____

Drilling and Remarks:

Oil 3333
Pay 3344-45 1/2
2000 acid
Pa 81179

RECORD

Cased _____ in., _____ ft.

Sand _____

Gas _____

Oil _____

Total Depth 3345 1/2

PRODUCTION

1st 24 hrs. Nat. _____

1st 24 hrs. after shot _____

Gas _____ Cu. Ft.

Dry Hole _____

Abandoned _____

Date

NOV 18 1936

19

S. J. LEWIS Scout